

SCOTT
H 27
8-11-75

MISSISSIPPI
BOARD OF WATER COMMISSIONERS
416 North State Street
Jackson, Mississippi 39201

WATER WELL DRILLERS LOG

8-11 1975 Scott Drilling Service Scott
date well completed firm name county well located

LANDOWNER: Billy Gordy
#1 Forest Miss
(mailing address)

description of formations encountered	from	to
Clay Clay + dirt	0	30
Sand	30	63

WELL LOCATION:
sec 2 T 7 N R 1 E
7 miles NE of Forest
(distance) (direction) (nearest town)

WELL PURPOSE: HOME
(home, irrigation, municipal, industrial)


- WELL COMPLETION DATA:
- (1) diameter (inches) 2"
 - (2) total depth (feet) 63
 - (3) static water level (feet) 15 below above top of ground.
 - (4) casing Steel 59
(material) (depth)
(size) if telescope see back.
 - (5) screen 4 59
(length) (depth to top)
1/4" Stainless Steel
(size) (material)
 - (6) pump 1/2 6
(HP) (yield gpm)
Electric
(type power)
 - (7) electric log NO
(yes or no)
 - (organization running log)
 - (8) how well bottom plugged

DRILLERS REMARKS:

REGISTERED
OCT 14 1975
MISS. Bd. OF WATER COM.

If well telescopes please sketch and show depths.

GROUND LEVEL

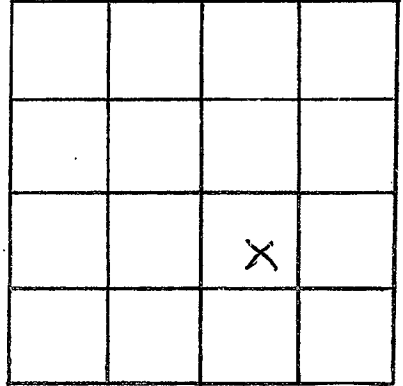

SECTION 21

Please indicate well location X.

ADDITIONAL INFORMATION

If more than one screen,
show locations of each on sketch.