State W	ell Report	ſ
	art 1	For Office Use Only:
County: <u>trat</u> <u>COTT</u> Mississippi Department	t of Environmental Quality	Aquifer:
Permit #: Office of Land a	nd Water Resources	Well #: <u>H-36</u>
	Box 10631 I S 39289-0631	L. S. Elevation:
Date drilling completed: $\frac{9}{2}$ $\frac{9}{2}$ $\frac{9}{2}$ $\frac{9}{2}$ $\frac{9}{2}$ (601)	961-5210	1
(601)35	4-6938 (fax)	E-log #:
State Law requires that this report be prepared by the 30 days of completion of drilling of the well.	driller in detail and filed w	vith the Department within
Well Owner Information	Wel	I Location
Owner Name Ronnic Thomas	Latitude:°'	_'' Longitude:'
Mailing Address: 3410 Ring old Ld	Method of Lat/Long (circle o	
	USGS quad, Hand-held	d GPS, Survey-grade GPS
Forrest Mg 37074 City State Zip Code	_	7 Rng_9E
• 	Distance Direction	Nearest Town of Lafer MS
Telephone No. (401 949 - 9513	Miles North	of happy ms
Well	Data	
Purpose of Well (circle one) Home Industrial Public Supply Irrigation Fish Culture Other:		
Date well drilling started: $\frac{9-27-06}{27-06}$ Date		
If flowing, method of flow regulation: Valve Other (tescribe)	· _ · · · · · · · · · · · · · · · · · ·
Static Water Level:feet above or below (circle one)	land surface Date measured	<u> 1-29-06</u>
Method of Measurement (circle one) steel tape electric tape air line other: 540.00		
Hole depth: <u>30</u> Well depth: <u>30</u>	_ Well grouted to a depth of	feet
Type of grout (circle one): Cement Bentonite Mix		2
Casing length: <u>60</u> feet Casing diameter: <u>4</u>	inches Type of casing:	JUC
Screen length: <u>2</u> C) feet Screen diameter: <u>4</u>	inches Type of screen:	PUC
Screen slot size: <u><i>H</i></u> <u><i>IC</i></u> inches Setting depth: From	60feet to	<u>80</u> feet
Type of completion (circle all applicable): Oravel packed Under	rreamed Telescoped Ope	en hole Natural Developmen
Other (describe):		
op of lap pipe or reduction in casing:feet. If telescoped or more than one screen, describe on back of page		
Logs run (circle all applicable). No log run Electric Gamma Ra	y Density Sonic Neutron	Other:
Name of organization running log(s):		
I certify that the well was drilled, constructed, and completed in	accordance with all applicabl	
Department of Environmental Quality and/or the Mississippi De	partment of Health regulation	ns and state laws.
0-374	2/100	nCan
Print Name of Water Well Contractor and License No.	' Signature	of Water Well Contractor
		RECEIV
		OCT 192
		001132


If well telescopes please sketch below and show depths.

H-36

RECEIVED,

OCT 1 9 2006

BY: OLWR

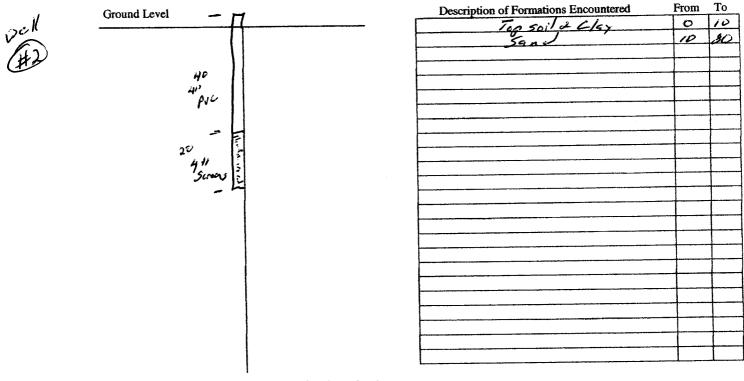

If more than one screen, show location of each on sketch

Sketch the property layout and include the following: 1) the well location; 2) any permanent structures on the property that may aid in locating the well; 3) any roads, power lines, or other items that may aid in locating the property and the well; 4) indicate direction.

Signature of Water Well Contractor

	STATE W	ELL REPORT	
,	County: \checkmark SCOTPump InstallerPermit #: \checkmark Mississippi DepartmeDriller: \checkmark \checkmark Office of LandDriller: \checkmark \checkmark Jackson, JDate completed: \checkmark \checkmark (601)3:	Part 2 For Office Use Only: 's Completion Report Aquifer: nt of Environmental Quality Aquifer: Box 10631 Well #: MS 39289-0631 Bevalue)961-5210 Elevation: 54-6938 (fax) Elevation:	
_	This report should be prepared by the pump installer in detail and filed with the Department within 30 days of the installation of pump.		
)	Well Owner Information	Well Location	
	Owner Name: Komie Thomas	Latitude: Longitude:	
	Mailing Address: 3410 Linggold	Method of Lat/Long (circle one): Conventional Survey, USGS quad, Hand-held GPS, Survey-grade GPS <u>5</u> <u>4</u> <u>4</u> <u>4</u> Sec <u>17</u> Twn <u>7</u> <u>M</u> Rng <u>5</u> <u>E</u>	
	Forest Ms 34074		
	City State Zip Code	Distance Direction Nearest Town	
1	Telephone No. (101) 469 - 9913	8 Miles North of Lake MS	
	L		
	Pump Type Circle one	Power Type Circle one	
	Air Lift Jet Submersible	Diesel Engine Gasoline Engine Natural Gas	
	Bucket Piston Turbine	Electric Motor Hand Tractor PTC	
	Centrifugal Rotary Flowing Well	Windmill Other (specify):	
	Other (specify):	Horse Power Rating of Motor: 5 hp	
	Date Pump Installed:	Setting Depth:feet	
	Rated Pump Capacity: Gallons Per Minute	Number of Stages:	
	Pump Test Data	Method of Measuring Water Level	
	Date Well Tested: <u>9-25-06</u>	Circle one	
	Static Water Level (A):Feet Below Land Surface	Air Line Electric Measuring Line Steel Tape	
	Pumping Water Level (B): <u>4</u> C Feet Below Land Surface	Other (specify):	
	Drawdown [(B) - (A)]:Feet Below Land Surface	For flowing well, measured shut in head:feet	
	Test Pumping Rate: Gallons Per Minute	Well yielded <u><u>g</u>d <u>GPM</u> with a drawdown of</u>	
	Duration of Pump Test (minimum 4 hours): hours	iccualiter (2) nours of numning	

1

RECEIVED OCT 1 9 2006 BY: OLWR