

Scott

H 2000

6-3-77

MISSISSIPPI
 BOARD OF WATER COMMISSIONERS
 416 North State Street
 13T Jackson, Mississippi 39201

WATER WELL DRILLERS LOG

Scott
Newton

6-3-77

Mrs Donald + Hill

date well completed

firm name

county well located

LANDOWNER:

allen McElhenny
Rt 2 Reaoter
(mailing address)

description of formations encountered

from

to

clay + sand 8 27

shale 27 30

sand 30 45

sandy shale 45 75

shale + sand 75 150

sand 150 220

sandy shale 220 240

shale 240 275

Rock + shale 275 295

green sand + sandy shale 295 300

WELL LOCATION:

sec 20 T 7 N R 9 E
 S
 12 1/2 miles NW of Lake
 (distance) (direction) (nearest town)

WELL PURPOSE:

home (home, irrigation, municipal, industrial)

WELL COMPLETION DATA:

(1) diameter (inches) 4"

(2) total depth (feet) 320'

(3) static water level (feet) 155' below top of ground.

(4) casing PVC 2 1/2" (material) (depth)

4" (size) if telescope see back.

(5) screen (length) (depth to top)

(size) (material)

(6) pump 3/4 (HP) 50 GPM (yield gpm)

E (type power)

(7) electric log (yes or no)

(organization running log)

(8) how well bottom plugged open


DRILLERS REMARKS:

RECEIVED
JUN 13 1977

MISS. BD. OF WATER COMMISSIONERS

If well telescopes please
sketch and show depths.

GROUND LEVEL

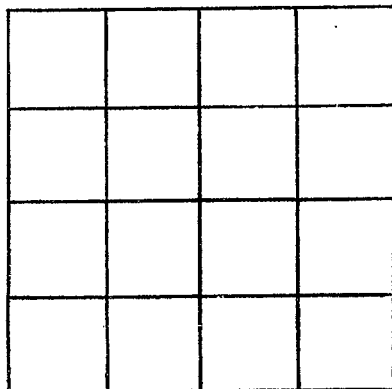

SECTION _____

Please indicate well location X.

ADDITIONAL INFORMATION

If more than one screen,
show locations of each on sketch.