

MISSISSIPPI
BOARD OF WATER COMMISSIONERS
416 North State Street
Jackson, Mississippi 39201

WATER WELL DRILLERS LOG

Scott
J 6
5-68

5-1 1968 date well completed Forest Drilling firm name Scott county well located

LANDOWNER: Fred Moore
Morton
Miss (mailing address)


WELL LOCATION:
sec 36 T 6 N R 6 E
S W
4 miles S/E of Morton
(distance) (direction) (nearest town)

WELL PURPOSE: Chicken Farm
(home, irrigation, municipal, industrial)

WELL COMPLETION DATA:

- (1) diameter (inches) 2"
- (2) total depth (feet) 523
- (3) static water level (feet) 168 below top of ground.
- (4) casing Galv. 508 (material) (depth)
- 2" if telescope see back. (size)
- (5) screen 154, 508 (length) (depth to top)
- 2" brass 1/2" (size) (material)
- (6) pump (HP) (yield gpm)
- (type power)
- (7) electric log No (yes or no)
- (organization running log) Kachuck & Kelue
- (8) how well bottom plugged


description of formations encountered	from	to
Clay & led sand & gravel	0	20
Blue Clay	20	204
Shale	204	276
Arg. & sths rock	276	285
Shale	285	300
Sandy Shell	300	327
Soft shale & sths 7' sand	327	389
Soft Shales	389	409
Soft Shale & sths 7' sand	409	430
Fine sand & shale	430	450
Silt	450	471
Soft shaly sths 7' sand	471	491
Soft Shale	491	500
Fine sand	500	532

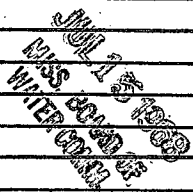

DRILLERS REMARKS:

If well telescopes please sketch and show depths.

GROUND LEVEL

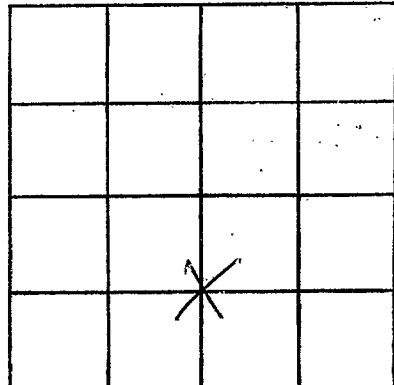

SECTION 36

Please indicate well location X.

ADDITIONAL INFORMATION

If more than one screen, show locations of each on sketch.