

SCOTT MISSISSIPPI BOARD OF WATER COMMISSIONERS

3 J 8-31-61 T WATER WELL DRILLERS LOG J

Date: 8/29 & 8/31/1961, Driller: Johnnie Beasley County: Scott.
(Name)


(1) Owner of Land: Roosevelt State Park.
 Turn South at Morton ^(Name) on Hwy. 13 and go
 Morton, Miss. _(Address)
 until you see Park Sign. ⁰¹⁰⁰⁰
 (2) Location: 1/4, 1/4, Sec. 33 T R
 miles of
 (distance) (direction) (Nearest Town)
 (3) Topography: X
 (Hilly) (Flat) (Level)
 (4) Purpose of Well: For Park use.
 (Domestic Irrigation
 Municipal, Industrial, Other)

Information upon completion of well:

(1) Diameter: 4 X 2 1/8" inches.
 (2) Total Depth: 915 feet.
 (3) Water Level: 250 feet below top of ground.
 (4) Cased to: See below, Size: 4 X 2 1/8"
 (5) Screen: Size 2 1/2", Length 30'
 (6) Were any formations sealed against pollution?
 yes, X no.
 If YES depth of formation
 Why
 Drillers Remarks: Good well

From 875' to 915' the re is 40' of
 2" pipe set as a tail piece.

Description & Color of Materials Sand, Clay, Red Clay, Shell, etc.	Thick-ness Feet	Depth Feet
Red sand.	0	10
Coarse sand.	10	35
Rock.	35	36
Sand & stks. clay.	36	42
Yellow clay.	42	58
Blue clay.	58	126
Rock.	126	128
Blue clay.	128	325
Shale & stks. lime rock.	325	370
Shale.	370	389
Lime, shell, shale & coal.	389	405
Blue shale.	405	422
Shale.	422	430
Silt sand & shale.	430	451
Shale & stks. sand.	451	471
Fine sand.	471	483
Shale.	483	530
Fine sand & stks. shale.	530	616
Fine sand. (Water no good)	616	668
Blue clay.	668	704
Shale & rock.	704	717
Shale & rock.	717	810
Soft shale.	810	817
Fine sand.	817	845
Sand. (30' Screen set here)	845	875
Shale.	875	887
Fine sand & stks. shale.	887	910
Shale.	910	915

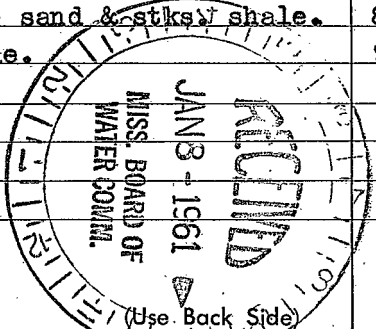

Well No.

...

...

