

SCOTT  
J/D  
4-66

WATER WELL DRILLERS LOG

P

Date: April, 1966, Driller: Roy Wilkerson County Scott  
(Name)


(1) Owner of Land: Lauree Jessums  
(Name)  
Morton, Miss  
(Address)  
(2) Location: 1/4, 1/4, Sec. 9 60-66 T. R.  
2 miles N.W., of Morton  
(distance) (direction) (Nearest Town)  
(3) Topography: Level  
(Hilly) (Flat) (Level)  
(4) Purpose of Well: Chicken Farm  
(Domestic Irrigation  
Municipal, Industrial, Other)

Description & Color of Materials - Sand, Clay, Red Clay, Shell, etc.	Thickness Feet	Depth Feet
<u>Sand - Blue Clay</u>	<u>20'</u>	
<u>Blue Clay</u>	<u>25'</u>	
<u>Rocky, Fine Stone</u>	<u>20'</u>	
<u>Green Sand</u>	<u>8'</u>	
<u>Blue Sand</u>	<u>5'</u>	
<u>Water Sand</u>	<u>60'</u>	
<u>Total</u>		<u>548'</u>

Information upon completion of well:

(1) Diameter 2 inches.  
(2) Total Depth 548 feet.  
(3) Water Level 140 feet below top of ground.  
(4) Cased to 548, Size 2"  
(5) Screen: Size 2", Length 10'  
(6) Were any formations sealed against pollution?  
\_\_\_\_\_ yes, \_\_\_\_\_ no.

If YES depth of formation \_\_\_\_\_  
Why \_\_\_\_\_  
Drillers Remarks: \_\_\_\_\_

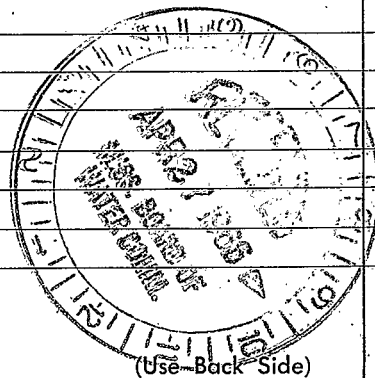

Well No.

MSW