


J. H. T.  
6-15-62

WATER WELL DRILLERS LOG

FOREST DRILLING SERVICE

Date: 6/15, 1962, Driller: FOREST DRILLING SERVICE Scott  
(Name)

		Description & Color of Materials Sand, Clay, Red Clay, Shell, etc.	Thick- ness Feet	Depth Feet
(1) Owner of Land: <u>Miss State Park Commission</u> <u>Rosevelt</u> (Name) <u>Meriton, Miss.</u> (Address)		<u>Silt</u>	<u>0</u>	<u>12</u>
(2) Location: <u>1/4</u> , <u>1/4</u> , Sec. <u>34</u> <u>5N1E</u> T. R. <u>3</u> miles <u>North</u> of <u>Meriton</u> (distance) (direction) (Nearest Town)		<u>Chalk w/ clay</u>	<u>6</u>	<u>18</u>
(3) Topography: <input checked="" type="checkbox"/> (Hilly) <input type="checkbox"/> (Flat) <input type="checkbox"/> (Level)		<u>Blue Clay</u>	<u>12</u>	<u>30</u>
(4) Purpose of Well: (Domestic Irrigation Municipal, Industrial, Other)		<u>Mucky Sand</u>	<u>16</u>	<u>46</u>
Information upon completion of well:		<u>Blue Clay</u>	<u>62</u>	<u>108</u>
(1) Diameter: <u>4" x 2 1/2"</u> inches.		<u>Blue Clay</u>	<u>207</u>	<u>315</u>
(2) Total Depth: <u>896</u> feet.		<u>fine shell</u>	<u>85</u>	<u>400</u>
(3) Water Level: <u>242</u> feet below top of ground.		<u>fine, shell + shale</u>	<u>20</u>	<u>420</u>
(4) Cased to: <u>866</u> , Size _____		<u>Mucky sand + shale</u>	<u>30</u>	<u>450</u>
(5) Screen: Size <u>26</u> , Length <u>30'</u>		<u>shale + mucky sand</u>	<u>18</u>	<u>468</u>
(6) Were any formations sealed against pollution? _____ yes, <input checked="" type="checkbox"/> no.		<u>fine sand</u>	<u>8</u>	<u>476</u>
If YES depth of formation _____		<u>shale + shls sand</u>	<u>26</u>	<u>490</u>
Why _____		<u>shale</u>	<u>99</u>	<u>589</u>
Drillers Remarks: _____		<u>fine sand</u>	<u>15</u>	<u>596</u>
		<u>shale</u>	<u>4</u>	<u>600</u>
		<u>fine sand</u>	<u>04</u>	<u>604</u>
		<u>shale + shls sand</u>	<u>20</u>	<u>624</u>
		<u>fine sand</u>	<u>14</u>	<u>645</u>
		<u>fine sand</u>	<u>35</u>	<u>670</u>
		<u>shale + rock</u>	<u>57</u>	<u>727</u>
		<u>shale + shls rock</u>	<u>85</u>	<u>812</u>
		<u>soft shale</u>	<u>20</u>	<u>832</u>
		<u>shale + soft clay</u>		<u>848</u>
		<u>shale + shls sand</u>		<u>852</u>
		<u>fine sand</u>		<u>883</u>
		<u>shls + shale</u>		<u>996</u>

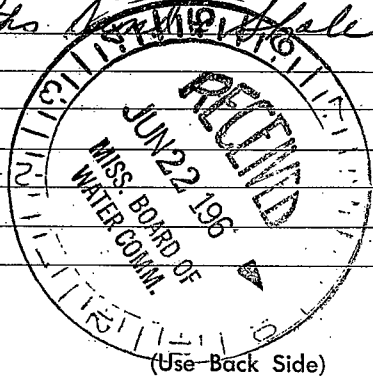

Well No.

