

# SCOTT MISSISSIPPI BOARD OF WATER COMMISSIONERS

J 12

4-21-65 WATER WELL DRILLERS LOG

Date: 4/21, 1965, Driller: Just Drilling County Scott  
 (Name)

(1) Owner of Land: J. J. Simpson  
 (Name)  
Merton, Miss.  
 (Address)

(2) Location: 1/4 1/4, Sec 21 T 1 R  
1/2 miles West of Merton  
 (distance) (direction) (Nearest Town)

(3) Topography: \_\_\_\_\_  
 (Hilly) (Flat) (Level)

(4) Purpose of Well: Home  
 (Domestic Irrigation  
 Municipal, Industrial, Other)

Description & Color of Materials Sand, Clay, Red Clay, Shell, etc.	Thick- ness Feet	Depth Feet
<u>Brown Clay</u>		<u>32</u>
<u>Blue clay</u>		<u>28.7</u>
<u>Rock + Shale</u>		<u>287</u>
<u>Shale + Shls Rock</u>		<u>277</u>
<u>Shale</u>		<u>287</u>
<u>Shale + Shls Rock</u>		<u>297</u>
<u>Sandy Shale</u>		<u>307</u>
<u>Soft Shale</u>		<u>312</u>
<u>Fine Sand + Shls Clay</u>		<u>322</u>
<u>Sand + Shls Clay</u>		<u>327</u>
<u>Clay</u>		<u>352</u>
<u>Clay + Shls Fine Sand</u>		<u>362</u>
<u>Fine Sand</u>		<u>367</u>
<u>Soft Shale</u>		<u>382</u>
<u>Soft Shale + Only Sand</u>		<u>402</u>
<u>Shale</u>		<u>529</u>
<u>Rock + Shls Shale</u>		<u>539</u>
<u>Fine Sand + Shls Clay</u>		<u>549</u>
<u>Soft Shale</u>		<u>566</u>
<u>Fine Sand</u>		<u>574</u>
<u>Fine Sand + Clay</u>		<u>584</u>
<u>Mucky Sand</u>		<u>594</u>
<u>Only Sand + Shls</u>		<u>604</u>
<u>Shale</u>		<u>614</u>

Information upon completion of well:

(1) Diameter 2 inches.

(2) Total Depth 614 feet.

(3) Water Level 159 feet below top of ground.

(4) Cased to 599, Size 2"


(5) Screen: Size 2", Length 15ft

(6) Were any formations sealed against pollution?  
 \_\_\_\_\_ yes,  no.

If YES depth of formation \_\_\_\_\_

Why \_\_\_\_\_

Drillers Remarks: \_\_\_\_\_

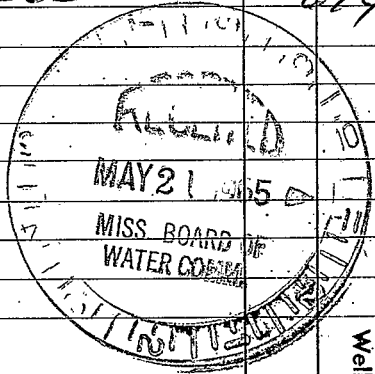

(Use Back Side)

Well No.

