

SCOTT MISSISSIPPI BOARD OF WATER COMMISSIONERS

WATER WELL DRILLERS LOG

6 J 14
7-15-66 T

Date: 7/15, 1966, Driller: Forest Drilling Co. Scott
(Name)

(1) Owner of Land: Ferne Cooper
(Name)

Merton, Miss.
(Address)

(2) Location: 1/4, 1/4, Sec. 20 T R
_____ miles _____ of _____
(distance) (direction) (Nearest Town)

(3) Topography: _____
(Hilly) (Flat) (Level)

(4) Purpose of Well: Home
(Domestic Irrigation, Municipal, Industrial, Other)

Description & Color of Materials Sand, Clay, Red Clay, Shell, etc.	Thick- ness Feet	Depth Feet
Red Sand	0	30
Blue Clay		135
Clay + Sths silt		145
Blue Clay		207
Shale		410
Shale + Sths Rock		512
lime shell + shale		574
Shale + Sths silt		574
Shale		595
Shale + Sths silt		617
Shale		659
lime sand		680
lime sand + Sths silt		690
lime sand		700

Information upon completion of well:

(1) Diameter 2 inches.

(2) Total Depth 700 feet.

(3) Water Level 260 feet below top of ground.

(4) Cased to 685, Size 2"

(5) Screen: Size 2", Length 15 ft.


(6) Were any formations sealed against pollution?

_____ yes, no.

If YES depth of formation _____

Why _____

Drillers Remarks: _____

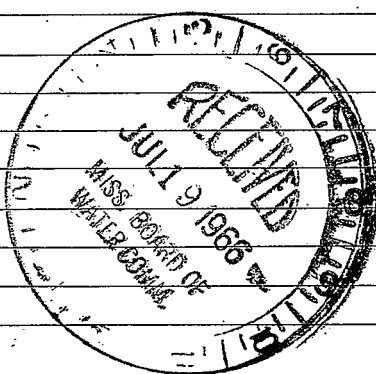

(Use Back Side)

Well No.

