

SCOTT

J 17

5-27-63

WATER WELL DRILLERS LOG

Date: 5/21, 1963, Driller: Frank Dery Scott County, Scott

(Name)

(1) Owner of Land: Curtis Davis
(Name)
Phillipchic, Miss
(Address)

(2) Location: 3 West 1/4, 1/4, Sec 21 T R
3 miles West of Proston
(distance) (direction) (Nearest Town)

(3) Topography: _____
(Hilly) (Flat) (Level)

(4) Purpose of Well: Chickens
(Domestic Irrigation
Municipal, Industrial, Other)

| Description & Color of Materials Sand, Clay, Red Clay, Shell, etc. | Thick- ness Feet | Depth Feet |
|---|------------------------|---------------|
| <u>Clay</u> | <u>0</u> | <u>30</u> |
| <u>Blue Clay</u> | | <u>245</u> |
| <u>Blue Shale + 1/2" lime</u> | | <u>322</u> |
| <u>Lime, Shell + sand</u> | | <u>347</u> |
| <u>fine sand</u> | | <u>365</u> |
| <u>Soft Clay</u> | | <u>388</u> |
| <u>Shale + 1/2" sand</u> | | <u>410</u> |
| <u>fine sand + 1/2" shale</u> | | <u>430</u> |
| <u>Mucky Shale</u> | | <u>457</u> |
| <u>Shale</u> | | <u>526</u> |
| <u>Fine sand</u> | | <u>532</u> |
| <u>Shale</u> | | <u>568</u> |
| <u>Fine Sand</u> | | <u>587</u> |

Information upon completion of well:

(1) Diameter 2" inches.

(2) Total Depth 587 feet.

(3) Water Level 130 feet below top of ground.

(4) Cased to 572, Size 2"


(5) Screen: Size 2", Length 15

(6) Were any formations sealed against pollution?
_____ yes, X no.

If YES depth of formation _____

Why _____

Drillers Remarks: _____

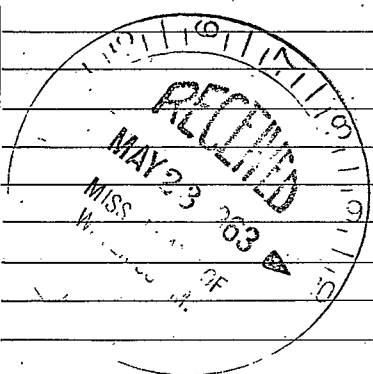

(Use Back Side)

Well No.

