

J 14
7-12-66

WATER WELL DRILLERS LOG

Date: 7/12, 1966, Driller: Furst Drilling County Scott
(Name)

(1) Owner of Land: Leo Jackson
(Name)
Rt 3 - Morton, Miss.
(Address)

(2) Location: 1/4, 1/4, Sec. 11 N W
_____ miles _____ of _____
(distance) (direction) (Nearest Town)

(3) Topography: ✓
(Hilly) (Flat) (Level)

(4) Purpose of Well: Home
(Domestic Irrigation
Municipal, Industrial, Other)

Description & Color of Materials Sand, Clay, Red Clay, Shell, etc.	Thick- ness Feet	Depth Feet
<u>Yellow Clay</u>	<u>0</u>	<u>30</u>
<u>Blue Clay</u>		<u>40</u>
<u>Shale</u>		<u>190</u>
<u>Silt + Shale</u>		<u>266</u>
<u>Shale</u>		<u>276</u>
<u>Silt + Shale</u>		<u>286</u>
<u>Shale</u>		<u>297</u>
<u>Fine Sand + Sh. Shale</u>		<u>338</u>
<u>Fine Sand</u>		<u>348</u>

Information upon completion of well:

(1) Diameter 2 inches.

(2) Total Depth 346 feet.

(3) Water Level 61 feet below top of ground.

(4) Cased to 336', Size 2"


(5) Screen: Size 2", Length 10ft.

(6) Were any formations sealed against pollution?
_____ yes, ✓ no.

If YES depth of formation _____

Why _____

Drillers Remarks: _____

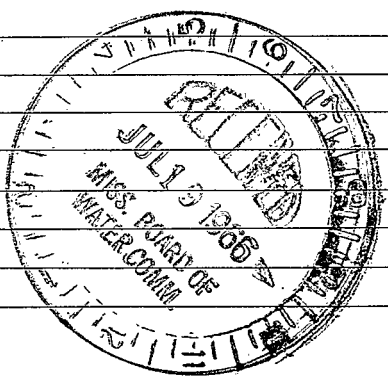

(Use Back Side)

Well No.

