

CODED

WATER WELL DRILLERS LOG

J 22
9-15-60
GW-860

Date: 9-15-, 1960, Driller: Layne Central Cops County Scott
(Name)

(1) Owner of Land: B. C. Rogers
(Name)

Morton, Mississippi
(Address)

(2) Location: 1/4, NE 1/4, Sec 23 T6R6,
_____ miles _____ of _____
(distance) (direction) (Nearest Town)

(3) Topography: _____
(Hilly) (Flat) (Level)

(4) Purpose of Well: Industrial
(Domestic Irrigation
Municipal, Industrial, Other)

Information upon completion of well:

- (1) Diameter 10 inches.
- (2) Total Depth 952 feet.
- (3) Water Level 252 feet below top of ground.
- (4) Cased to 880', Size 10"
- (5) Screen: Size 6", Length 60'
- (6) Were any formations sealed against pollution?
x yes, _____ no.


If YES depth of formation 880'

Why Required

Drillers Remarks:

Description & Color of Materials Sand, Clay, Red Clay, Shell, etc.	Thick- ness Feet	Depth Feet
Top soil	0-5	5
Red Clay	5-43	38
Gummy shale	43-370	323
Shale-stks sand	370-473	103
Hard pk sand	473-574	101
Hard shale-rock	574-703	129
Rock	703-704	1
Hard shale-rock	704-722	18
Sandy shale	722-768	46
Hard shale	768-790	22
Fine sand-strks	790-880	90
Medium sand	880-950	70
Shale	950-968	18

CODED

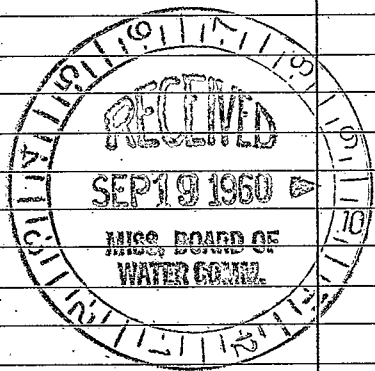

(Use Back Side)

Well No.

(8)