

Scott  
17 T 23  
3-67

MISSISSIPPI  
 BOARD OF WATER COMMISSIONERS  
 416 North State Street  
 Jackson, Mississippi 39201

WATER WELL DRILLERS LOG

3-4 1967 Scott Drilling Scott  
 date well completed firm name county well located

LANDOWNER: Fred Moore

description of formations encountered

from to

Dorton, Miss  
 (mailing address)

WELL LOCATION:

sec 24 T 6N R 6E  
~~1/2~~ 1/2 miles West of Dorton  
 (distance) (direction) (nearest town)

WELL PURPOSE: Chickens  
 (home, irrigation, municipal, industrial)


WELL COMPLETION DATA:

- (1) diameter (inches) 2"
- (2) total depth (feet) 540
- (3) static water level (feet) 158 below above top of ground.
- (4) casing Galv., 525,  
 (material) (depth)  
2"  
 (size) if telescope see back.
- (5) screen 15ft,  
 (length) (depth to top)  
2", Stainless Steel  
 (size) (material) (Coated)
- (6) pump 3 800  
 (HP) (yield gpm)  
Elect  
 (type power)
- (7) electric log 0/0  
 (yes or no)

(organization running log)

(8) how well bottom plugged backwash  
blue


<u>Brown</u>	<u>0</u>	<u>20</u>
<u>Blue Clay</u>	<u>270</u>	
<u>shale + lime rock</u>	<u>226</u>	
<u>shale</u>	<u>268</u>	
<u>Spindly Shell</u>	<u>290</u>	
<u>shale</u>	<u>296</u>	
<u>shale + silt sand</u>	<u>318</u>	
<u>fine sand + shale</u>	<u>430</u>	
<u>soft shale + silt sand</u>	<u>450</u>	
<u>fine sand</u>	<u>491</u>	
<u>fine sand + silt clay</u>	<u>512</u>	
<u>fine sand</u>	<u>512</u>	
<u>clay + silt sand</u>	<u>568</u>	

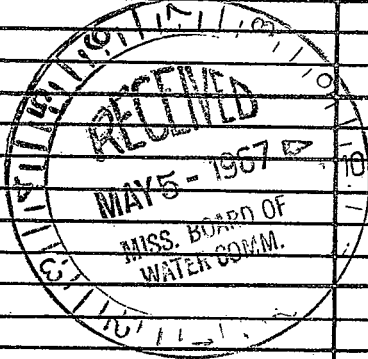

DRILLERS REMARKS:

If well telescopes please sketch and show depths.

GROUND LEVEL

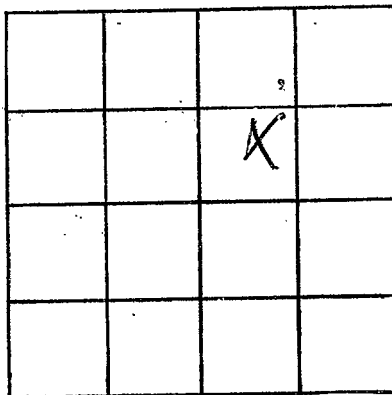

SECTION 21

Please indicate well location X.

ADDITIONAL INFORMATION

If more than one screen,  
show locations of each on sketch.