

WATER WELL DRILLERS LOG

Date: 9/8, 1964, Driller: Forest Dilling County: Scott  
 (Name)

(1) Owner of Land: Sam Hennigan  
 (Name)  
Morton  
 (Address)

(2) Location: 1/4, 1/4, Sec. 11 T. 5 R. 1  
1 1/2 miles North of Morton  
 (distance) (direction) (Nearest Town)

(3) Topography:  (Hilly)  (Flat)  (Level)

(4) Purpose of Well: Home  
 (Domestic Irrigation, Municipal, Industrial, Other)

Description & Color of Materials Sand, Clay, Red Clay, Shell, etc.	Thick- ness Feet	Depth Feet
<u>Brown Clay</u>	<u>0</u>	<u>28</u>
<u>Blue Clay</u>		<u>222</u>
<u>Clay + Lime Rock</u>		<u>232</u>
<u>Clay</u>		<u>282</u>
<u>Clay + Shell Rock</u>		<u>292</u>
<u>Hardy Shell + other</u>		<u>302</u>
<u>Soft White Rock</u>		<u>322</u>
<u>Shale</u>		<u>342</u>
<u>Shale + shells + phy. sand</u>		<u>372</u>
<u>Fine sand + thin clay</u>		<u>382</u>
<u>phy sand + soft shale</u>		<u>402</u>
<u>Fine sand</u>		<u>409</u>
<u>Shale</u>		<u>432</u>
<u>Shale + shells + F. sand</u>		<u>492</u>
<u>F. sand + shell clay</u>		<u>532</u>
<u>Fine sand</u>		<u>542</u>
<u>Fine sand + shell clay</u>		<u>552</u>
<u>Fine sand</u>		<u>558</u>

Information upon completion of well:

(1) Diameter: 2 inches.

(2) Total Depth: 556 feet.

(3) Water Level: 165 feet below top of ground.

(4) Cased to: 546, Size: 2"


(5) Screen: Size 2", Length 10ft

(6) Were any formations sealed against pollution?  
 \_\_\_\_\_ yes,  no.

If YES depth of formation \_\_\_\_\_

Why \_\_\_\_\_

Drillers Remarks: \_\_\_\_\_

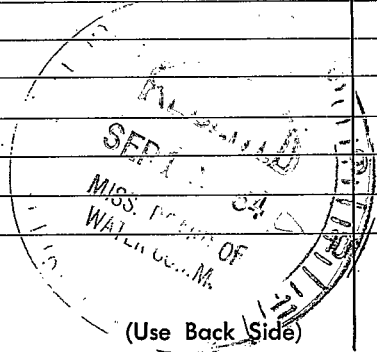

Well No. \_\_\_\_\_

