

SCOTT
 J 25
 3-68

MISSISSIPPI
 BOARD OF WATER COMMISSIONERS
 416 North State Street
 Jackson, Mississippi 39201

WATER WELL DRILLERS LOG

March 19 68 date well completed
 Wilkerson Drilling firm name
 SCOTT county well located

LANDOWNER: PAUL Nichol
 Hwy 483 N
 Morton MISS
 (mailing address)

WELL LOCATION:
 sec 15 T 6 N R 6 E
 S W
 2 miles N of Morton
 (distance) (direction) (nearest town)

WELL PURPOSE: home
 (home, irrigation, municipal, industrial)

- WELL COMPLETION DATA:
- (1) diameter (inches) 2"
 - (2) total depth (feet) 510"
 - (3) static water level (feet) 168' below top of ground.
 - (4) casing GALV. 504' (material) (depth)
 2" (size) if telescope see back.
 - (5) screen 6' 510' (length) (depth to top)
 2" (size) 6-ASS (material)
 - (6) pump 3 (HP) 14 (yield gpm)
 Elec (type power)
 - (7) electric log No (yes or no)
 (organization running log)
 - (8) how well bottom plugged 2-2" BWL


description of formations encountered	from	to
Yellow clay	0	35'
blue w/	35	180
Backe clay	180	188'
blue clay	188	250
Rock & shale	250	280
hard Rock	280	282
blue shale	282	309
sand & shale	309	450
Rock & sand	450	460
Fine sand	460	478
Good sand	478	510
Fine sand	510	530

DRILLERS REMARKS:

MAY 9 1968
 MISS. Bd. of WATER COMM.

If well telescopes please sketch and show depths.

GROUND LEVEL

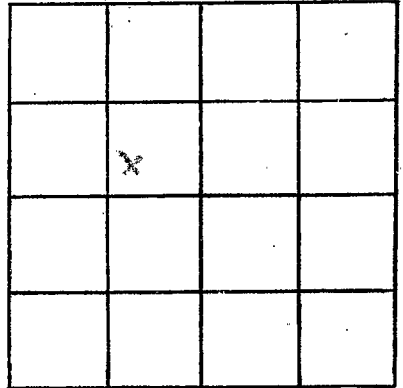

SECTION 15

Please indicate well location X.

ADDITIONAL INFORMATION

If more than one screen, show locations of each on sketch.