

Scott  
Q 26 CODED  
6-68

MISSISSIPPI  
 BOARD OF WATER COMMISSIONERS  
 416 North State Street  
 Jackson, Mississippi 39201

WATER WELL DRILLERS LOG

June 1968 Wilkinson Drilling Scott  
 date well completed firm name county well located

LANDOWNER: Mr. E. W. Wilkinson  
Merton Miss  
 (mailing address)

WELL LOCATION:  
 sec. 15 T. 6 (N) S R. 6 (E) W  
1 3/4 miles N of Merton  
 (distance) (direction) (nearest town)

WELL PURPOSE: home  
 (home) irrigation, municipal, industrial

- WELL COMPLETION DATA:
- (1) diameter (inches) 2"
  - (2) total depth (feet) 468
  - (3) static water level (feet) 138 below above top of ground.
  - (4) casing Galv. 462  
 (material) (depth)  
2"  
 (size) if telescope see back.
  - (5) screen 6 462  
 (length) (depth to top)  
2 BRASS  
 (size) (material)
  - (6) pump 3 12  
 (HP) (yield gpm)  
elec  
 (type power)
  - (7) electric log No  
 (yes or no)  
 (organization running log)
  - (8) how well bottom plugged 2 B.W.C.

description of formations encountered	from	to
<u>Yellow clay</u>	<u>0</u>	<u>30</u>
<u>Blue li.</u>	<u>30</u>	<u>150</u>
<u>Rock</u>	<u>150</u>	<u>155</u>
<u>Blue li.</u>	<u>152</u>	<u>240</u>
<u>Red Mt. shale</u>	<u>240</u>	<u>280</u>
<u>Shale</u>	<u>280</u>	<u>350</u>
<u>Brown shale &amp; sand</u>	<u>350</u>	<u>420</u>
<u>Sand</u>	<u>420</u>	<u>468</u>


CODED

JUN 26 1968  
 MISS. BOARD OF  
 WATER COMMISSIONERS

DRILLERS REMARKS:

If well telescopes please sketch and show depths.

GROUND LEVEL

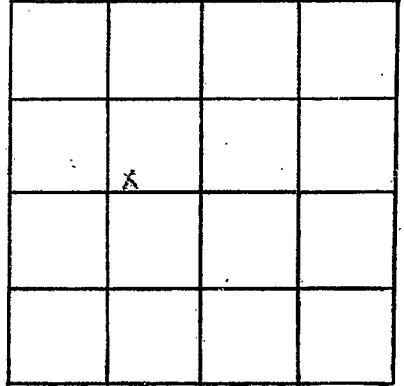

SECTION 15

Please indicate well location X.

ADDITIONAL INFORMATION

If more than one screen,  
show locations of each on sketch.