

**MISSISSIPPI
BOARD OF WATER COMMISSIONERS**
416 North State Street
Jackson, Mississippi 39201

CODED

WATER WELL DRILLERS LOG

Feb 1969 Wilkinson Drilling Service SCOTT
date well completed firm name county well located

LANDOWNER: Louise Boyd

description of formations encountered

from to

Morton MISS
(mailing address)

| | | |
|-------------------------------|------------|------------|
| <u>Yellow clay</u> | <u>0</u> | <u>40</u> |
| <u>Blue</u> | <u>40</u> | <u>210</u> |
| <u>Blue clay & pack</u> | <u>210</u> | <u>280</u> |
| <u>Black & Green sand</u> | <u>280</u> | <u>305</u> |
| <u>+ shale</u> | | |
| <u>blue</u> | <u>305</u> | <u>400</u> |
| <u>Fine sand & shale</u> | <u>400</u> | <u>450</u> |
| <u>Brown shale & sand</u> | <u>450</u> | <u>495</u> |
| <u>hard shale</u> | <u>495</u> | <u>501</u> |
| <u>Fine sand</u> | <u>501</u> | <u>525</u> |
| <u>streaks of sand</u> | <u>525</u> | <u>533</u> |
| <u>sand</u> | <u>533</u> | <u>544</u> |
| <u>sand</u> | <u>544</u> | <u>549</u> |
| <u>hard sand & shale</u> | <u>549</u> | <u>565</u> |

WELL LOCATION:

sec. 15 T. 6 N. R. 6 E.
S W
2 miles North of Morton
(distance) (direction) (nearest town)

WELL PURPOSE: home
(home, irrigation, municipal, industrial)

WELL COMPLETION DATA:

- (1) diameter (inches) 2
- (2) total depth (feet) 544
- (3) static water level (feet) 154 below above top of ground.
- (4) casing GALV, 534,
(material) (depth)
 if telescope see back.
(size)
- (5) screen 10, 544
(length) (depth to top)
2, Stanwell Steel
(size) (material)
- (6) pump 1 1/2 Jt 5
(HP) (yield gpm)
Elec
(type power)
- (7) electric log NO
(yes or no)

(organization running log)
- (8) how well bottom plugged 2-2" B.W.


DRILLERS REMARKS:

MAR 5 1969

MISS. BD. OF
WATER COMM.

If well telescopes please sketch and show depths.

GROUND LEVEL

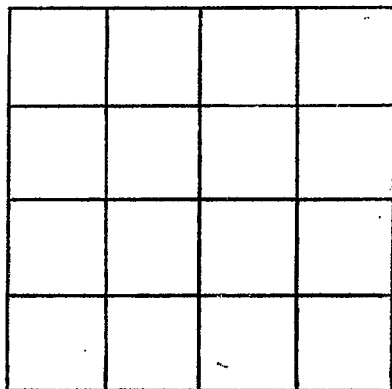

SECTION 15

Please indicate well location X.

ADDITIONAL INFORMATION

If more than one screen,
show locations of each on sketch.