

SCOTT
J30
7-10-70

MISSISSIPPI
BOARD OF WATER COMMISSIONERS
416 North State Street
Jackson, Mississippi 39201

CODED

WATER WELL DRILLERS LOG

July 10 1970 date well completed
Wilkinson Drilling Service, Inc. firm name
Scott county well located

LANDOWNER: Clare Flanagan

description of formations encountered

from to

Morton, Missis
(mailing address)

yellow clay	0	27
Blue Clay	27	190
Rock layers	190	200
Blue Clay	200	260
yellow clay	260	305
Dark Fine Sand	305	400
Fine Sandy Clay	400	450
Water Sand	450	483

WELL LOCATION:
sec. 16 T. 6N R. 6E
2 1/2 miles North of Morton
(distance) (direction) (nearest town)

WELL PURPOSE: Home
(home, irrigation, municipal, industrial)

WELL COMPLETION DATA:

- (1) diameter (inches) 2
- (2) total depth (feet) 483
- (3) static water level (feet) 200 below above top of ground.
- (4) casing galv. 483
(material) (depth)
- if telescope see back.
(size)
- (5) screen 6 483
(length) (depth to top)
2x6 Stainless Steel
(size) (material)
- (6) pump 3 20
(HP) (yield gpm)
elec
(type power)
- (7) electric log no
(yes or no)

CODED

(organization running log)

(8) how well bottom plugged B.W.V.


AUG 17 1970

DRILLERS REMARKS:

MISS. STATE
WATER

If well telescopes please sketch and show depths.

GROUND LEVEL

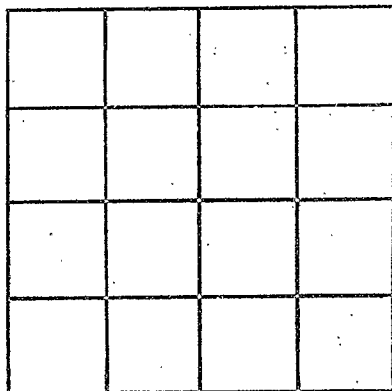

SECTION _____

Please indicate well location X.

ADDITIONAL INFORMATION

If more than one screen, show locations of each on sketch.