

MISSISSIPPI DEPARTMENT OF NATURAL RESOURCES

Bureau of Land and Water Resources

Southport Mall

P.O. Box 10631

Jackson, Mississippi 39209

WATER WELL DRILLERS LOG

CODED

SCOTT
J 34
9/19/80
Elog #135

Sept. 19 1980 E.M. "Bud" Cresswell Scott  
 date well completed firm name county well located

LANDOWNER:  
 Shell Oil Co. - New Orleans.  
 STUART Et. Al No. 1. LA.  
 (mailing address)

description of formations encountered	from	to
Clay	0	270
Sand/Shell	270	290
Sandy-shale	290	400
Sand	400	430
Sandy-shale	430	500
Sand	500	560

WELL LOCATION:  
 sec. 1 T. 6 N R. 5 E  
 6 miles NE of Patches  
 (distance) (direction) (nearest town)

WELL PURPOSE: Industrial  
 (home, irrigation, municipal, industrial)

WELL COMPLETION DATA:

(1) diameter (inches) 3 5/8  
 (2) total depth (feet) 660  
 (3) static water level (feet) 110 below top of ground. 520 above  
 (4) casing Steel 620 (material) (depth)  
 3 (size) if telescope see back 520  
 (5) screen 40 620 (length) (depth to top)  
 3 STAINLESS (size) (material)  
 (6) pump Air Comp. 70 (HP) (yield gpm)  
 0 (type power)  
 (7) electric log yes (yes or no)  
 Hall (organization running log)  
 (8) how well bottom plugged  
 Backwash Valve

CODED

DEPT. OF NATURAL RESOURCES  
 BUREAU OF LAND & WATER RESOURCES


OCT 17 1980

RECEIVED

DRILLERS REMARKS:

If well telescopes please sketch and show depths.

GROUND LEVEL

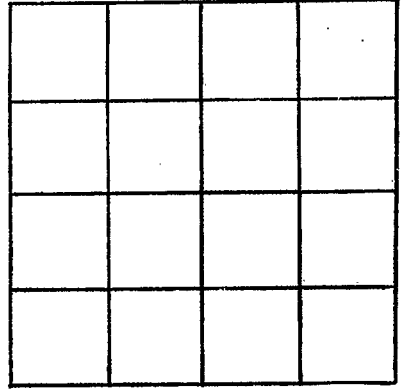

SECTION \_\_\_\_\_

Please indicate well location X.

ADDITIONAL INFORMATION

If more than one screen,  
show locations of each on sketch.