

SCOTT

J 35

12/1982

GW-1422

MISSISSIPPI
 BOARD OF WATER COMMISSIONERS
 416 North State Street
 Jackson, Mississippi 39201

CODED

WATER WELL DRILLERS LOG

19 Herndon Well & Supply, Inc. Scott
 date well completed firm name county well located

LANDOWNER: City of Morton
Morton, MS 39117
 Well #4
 (mailing address)

description of formations encountered	from	to
Brown Clay	0	37
Blue Clay	37	330
Brown Clay w/Sand Streaks	330	520
Sandy Blue Clay	520	590
Gray Clay	590	770
Sand	770	800
Blue Clay	800	840
Sand	840	935
Blue Clay		935
Total Depth		

WELL LOCATION:
 sec. 26 T 6 N R 6 E
 Inside City limits
 (distance) miles (direction) of (nearest town)

WELL PURPOSE: Municipal
 (home, irrigation, municipal, industrial)

WELL COMPLETION DATA:

- (1) diameter (inches) 16" X 8"
- (2) total depth (feet) 935
- (3) static water level (feet) 293 below top of ground.
- (4) casing Steel, 372' (material), (depth)
16" (size) if telescope see back.
- (5) screen 91.86, 843.14 (length), (depth to top)
8" (size), SS Ribbed (material)
- (6) pump 125, 686 (HP), (yield gpm)
electric (type power)
- (7) electric log yes (yes or no)
USGS Bureau Geology (organization running log)
- (8) how well bottom plugged 8" BWV

CODED

DEPT. OF NATURAL RESOURCES
 BUREAU OF LAND & WATER RESOURCES

JAN 19 1983

RECEIVED

DRILLERS REMARKS:

(K)



If well telescopes please sketch and show depths.

GROUND LEVEL

Top of Lap 764.60

Top of Screen 843.14

Bottom Well 935'

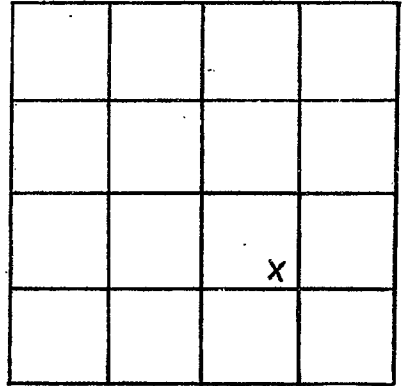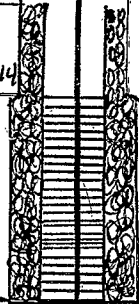

SECTION 26

Please indicate well location X.

ADDITIONAL INFORMATION

If more than one screen,
show locations of each on sketch.