

SCOTT  
 J36  
 1-15-83  
 Elog #139

MISSISSIPPI  
 BOARD OF WATER COMMISSIONERS  
 416 North State Street  
 Jackson, Mississippi 39201  
 WATER WELL DRILLERS LOG

CODE

GW-1424

83 Herndon Well & Supply, Inc. Scott  
 date well completed firm name county well located

LANDOWNER: City of Morton	description of fomations encountered		from
Morton, MS 39117	Brown Clay	0	25
Well No. 3	Blue Rock	25	70
(mailing address)	Sand w/Clay Streaks	70	360
<b>WELL LOCATION:</b>	Sandy Clay	360	600
sec. 23 T 6 N R 6 E	Blue Clay	600	644
Inside city limits	Rock	644	645
(distance) miles (direction) of (nearest town)	Sandy Clay <b>CODED</b>	645	655
<b>WELL PURPOSE:</b> Municipal	Rock	655	657
(home, irrigation, municipal, industrial)	Clay	657	675
<b>WELL COMPLETION DATA:</b>	Rock	675	676 1/2
(1) diameter (inches) 16 x 8-Inch	Sandy Clay	676 1/2	762
(2) total depth (feet) 865'	Sand	762	912
(3) static water level (feet) 233.4 below top of ground.	Sandy Clay	912	1050
(4) casing Steel 737'	Rock	1050	1052
(material) (depth)	Clay	1052	
16" if telescope see back.			
(size)			
(5) screen 122.17 742.82			
(length) (depth to top)			
8" SS Ribbed			
(size) (material)			
(6) pump 100 554			
(HP) (yield gpm)			
electric			
(type power)			
(7) electric log yes			
(yes or no)			
Bureau of Geology			
(organization running log)			
(8) how well bottom plugged 8" BWV			

DEPT. OF NATURAL RESOURCES  
 BUREAU OF LAND & WATER RESOURCES

MAY 2 - 1983

RECEIVED

DRILLERS REMARKS:

If well telescopes please sketch and show depths.

GROUND LEVEL

1/6" Casing 737'


Top of 8" LAP  
677.20'

Top of screen  
742.82

110' of 8" Screen  
10' of 8" Blank  
12.17' of 8" Screen

Bottom of well  
865'

If more than one screen,  
show locations of each on sketch.

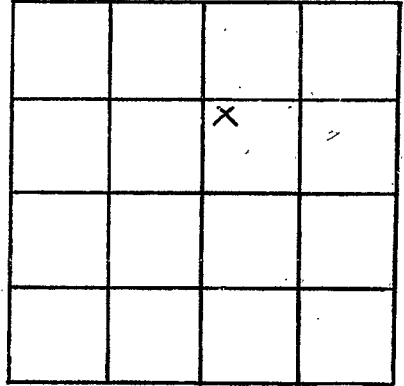

SECTION 23

Please indicate well location X.

ADDITIONAL INFORMATION

Multiple horizontal lines for additional information.