

Scott
J 42
10-19-68

MISSISSIPPI
 BOARD OF WATER COMMISSIONERS
 416 North State Street
 Jackson, Mississippi 39201

CODED

WATER WELL DRILLERS LOG

10-19 1968 Conroy Drilling Scott
 date well completed firm name county well located

LANDOWNER: Elean Wall

description of formations encountered

from to

P.O. Box 374 Marton
Miss
 (mailing address)

Red Clay 0 20
Red Bank Clay 20 43

WELL LOCATION:

sec. 13 T. 6 N. S. R. 6 E. W.
1/2 miles N.E. of Marton
 (distance) (direction) (nearest town)

Dark Clay 43 260
Dark Clay & Shell 260 408

WELL PURPOSE: Home
 (home, irrigation, municipal, industrial)

Fine Sand & Clay 408 489
Clear Sand 489 574

WELL COMPLETION DATA:

- (1) diameter (inches) 1 1/2
- (2) total depth (feet) 574
- (3) static water level (feet) 190 below above top of ground.
- (4) casing Steel, 504,
 (material) (depth)
 _____ if telescope see back.
 (size)
- (5) screen 10, 504
 (length) (depth to top)
1 1/4, 5/8
 (size) (material)
- (6) pump Common 300
 (HP) (yield gpm)

 (type power)
- (7) electric log X
 (yes or no)

 (organization running log)
- (8) how well bottom plugged 3/4 ash

CODED


FEB 12 1969

MISS. BD. OF
 WATER COMM.

DRILLERS REMARKS:

If well telescopes please sketch and show depths.

GROUND LEVEL

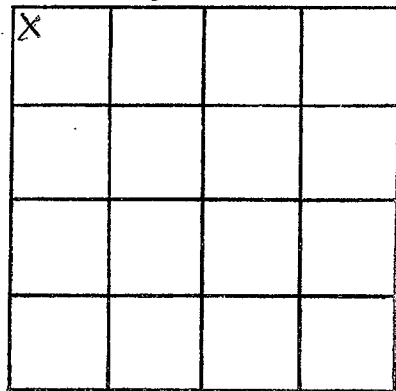

SECTION 13

Please indicate well location X.

ADDITIONAL INFORMATION

If more than one screen,
show locations of each on sketch.