
County: MS-GW-16027 Mississipi Department of Environmental Quality Molfred M	County: MS-GW-16027 Permit #: MS-GW-16027 Driller: LAYNE-CENTRAL Date Drilling Completed: \$11906 State Law requires that this report be prepared by the driller in detail and filed with the Department within 30 days of completion of drilling of the well. Information on Well Owner (Landowner if browcholes is not for a water well) Owner Name KOCH FOODS Mailing Address: 4688 HIGHWAY 80 MORTON MS 39117 City State Zip Code Method of Lat/Long (circle one): North of HIGHWAY 80 Well Data Purpose of Well (circle one): Home Industrial Public Supply Irrigation Fish Culture Other: —— Purpose of Well (circle one): Home Date well drilling completed: \$11906 Method of Measurement (circle one) steel tape electric tape air line Other: —— Static Water Level: 334 feet above or below (circle one) and surface Date Measured: \$5117/06 Method of Measurement (circle one): See tape electric tape air line Other: —— Hole depth: 880' Well depth: 880' Well grouted to a depth of: 790 feet Type of grout (circle one): Cement Bentonite Mix Casing length: 790 feet Casing diameter: 16 inches Type of sang: COATED STEEL Screen length: 80 feet Screen diameter: 10 inches Type of sang: COATED STEEL Screen length: 80 feet Screen diameter: 10 inches Type of sang: COATED STEEL Screen length: From 800 feet to 880 feet Type of completion (circle all applicable): Gravel Packed Underreamed Telescoped Open Hole Natural Dev	County: SCOTT Well Driller Report and Well Log Mississippi Department of Environmental Quality Well #: J. L.	and the same of th	1		For Office Use Only:	
Permit #: MS-GW-16027 Driller: LAYNE-CENTRAL Date Drilling Completed: 5/19/06 State Law requires that this report be prepared by the driller in detail and filed with the Department within State Law requires that this report be prepared by the driller in detail and filed with the Department within 30 days of completion of drilling of the well. Information on Well Owner (Landowner if borehole is not for a water well) Owner Name KOCH FOODS Mailing Address: 4688 HIGHWAY 80 MORTON MS 39117 City State Zip Code Telephone No. (601) 732-8911 Well Data Purpose of Well (circle one): Home Industrial Public Supply Irrigation Fish Culture Other: Date well drilling started: 274/06 Date well drilling started: 34 feet above or below (circle one) land surface Other (describe) Static Water Level: 334 feet above or below (circle one) land surface Date Method of Measurment (circle one): Steel tape clectric tape air line Other: Type of grout (circle one): Cernent Bentonite Method of Measurment (circle one): Steel tape clectric tape air line Other: Type of completion (circle all applicable): Gravel Packed Underreamed Telescoped Open Hole Natural Development Other (describe): Top of lap pipe or reduction in casing: 716 Feet. If telescoped or more than one screen, describe on back of page. LAYNE-CENTRAL. JACKSON, MS	Permit #: MS-GW-16027 Driller: LAYNE-CENTRAL Date Drilling Completed: 5/19/06 State Law requires that this report be prepared by the driller in detail and filed with the Department within 30 days of completion of drilling of the well. Information on Well Owner (Landowner if Deroble is not for a water well) Owner Name KOCH FOODS Mailing Address: 4688 HIGHWAY 80 MORTON MS 39117 City State Zip Code MORTON MS 39117 City State Zip Code Telephone No. (601) 732-8911 Well or Borehole Location Well or Borehole Location Say 2 1/ 22 55 Soy 33/ 25.05 Latitude: N 32.21382 Longitude: W 689.39418 Method of Lat/Long (Grele one): Conventional Survey USGS quad, Hand-Held GPS. Survey-grade GPS Set Soy Well Distance Direction Nearest Town Nearest Town Nearest Town 1000 FEET Miles NORTH of HIGHWAY 80 Well Data Purpose of Well (circle one): Home Industrial Public Supply Irrigation Fish Culture Other: Date well drilling completed: 5/19/06 If flowing, method of flow regulation: Valve Other (describe) — Static Water Level: 334 feet above or below (circle one) land surface Date Measured: 5/17/06 Method of Measurement (circle one): See latape electric tape air line Other: Type of grout (circle one): Cement Bentonite Mix Sec Soy 1/20 Soy Well grouted to a depth of: 790 feet Type of grout (circle one): Cement Bentonite Mix Sec Soy 1/20 Soy Survey-grade GPS Setting depth: From 800 feet to 880 feet Type of completion (circle all applicable): Gravel Packed Underreamed Telescoped Open Hole Natural Development Other (describe): — Top of lap pipe or reduction in casing: 716 feet. **Itelescoped or more than one screen, describe on back of page. Logs run (circle all applicable): No log run Electric Gamma Ray Density Sonic Neutron Other: — Name of organization running log(s): LAYNE-CENTRAL, JACKSON, MS	Permit #: MS-GW-16027 Driller: LAYNE-CENTRAL Date Drilling Completed: 5/19/06 State Law requires that this report be prepared by the driller in detail and filed with the Department within 15/210 (601) 361-5210 State Law requires that this report be prepared by the driller in detail and filed with the Department within 15/24-6938 (fax) State Law requires that this report be prepared by the driller in detail and filed with the Department within 15/24-6938 (fax) State Law requires that this report be prepared by the driller in detail and filed with the Department within 15/24-6938 (fax) State Law requires that this report be prepared by the driller in detail and filed with the Department within 15/24-6938 (fax) State Law requires that this report be prepared by the driller in detail and filed with the Department within 15/24-6938 (fax) State Law requires that this report be prepared by the driller in detail and filed with the Department within 15/24-6938 (fax) State Law requires that this report be prepared by the driller in detail and filed with the Department within 15/24-6938 (fax) State Law requires that this report be prepared by the driller in detail and filed with the Department within 15/24-6938 (fax) Say 15/24-6938 (fax) Lastitude: N 32.21382 Lasti	County: SCOTT				
Driller: LAYNE-CENTRAL Jackson, MS 39289-0631 (601) 354-6938 (fax) E-Log #: E-Lo	Driller: LAYNE-CENTRAL Date Drilling Completed: 5/19/06 State Law requires that this report be prepared by the driller in detail and filed with the Department within 3 days of completion of drilling of the welt. Information on Well Owner (Landowner if borehole is not for a water well) Owner Name KOCH FOODS Mailing Address: 4688 HIGHWAY 80 MORTON MS 39117 City State Zip Code Telephone No. (601) 732-8911 Well Data Purpose of Well (circle one): Home Industrial Public Supply Irrigation Fish Culture Other: — Date well drilling started: 2/24/06 Date well drilling completed: 5/19/06 If flowing, method of flow regulation: Valve — Other (describe) — Static Water Level: 334 feet above or below (circle one) land surface Method of Measurement (circle one) steel tape electric tape air line Other: — Hole depth: 880' Well depth: 880' Well grouted to a depth of: 790 feet Casing length: 790 feet Casing diameter: 16 inches Type of casing: COATED STEEL Screen length: 80 feet Screen diameter: 10 inches Type of serven: STAINLESS STEEL Screen length: 790 feet Casing diameter: 16 inches Type of serven: STAINLESS STEEL Screen length: From 800 feet to 880 feet Type of completion (circle all applicable): Gravel Packed Underreamed Telescoped Open Hole Natural Development Other (describe) — Top of lap pipe or reduction in casing: 716 feet. If telescoped or more than one screen, describe on back of page. L. S. Elevation: E-Log #: E-Log #: Latitude with the Department within 30 4921 20 55 50 50 50 50 50 50 50 50 50 50 50 50	Driller: LAYNE-CENTRAL Date Drilling Completed: \$1906 State Law requires that this report be prepared by the driller in detail and filed with the Department within 30 days of completion of drilling of the well. Information on Well Owner (Landowner flobrehole is not for a water well) Owner Name KOCH FOODS Mailing Address: 4688 HIGHWAY 80 MORTON MS 39117 City State Zip Code Telephone No. (601) 732-8911 Telephone No. (601) 732-8911 Well Data Well Data Well Orbert Miles NORTH of HIGHWAY 80 Telephone No. (601) 732-8911 Well Data Well Data	Permit #- MS_CW_16027			Well #: 7. 46	
Date Drilling Completed: \$1906	State Law requires that his report be prepared by the driller in detail and filed with the Department within 30 days of completion of drilling of the well. Information on Well Owner (Landowner if borehole is not for a water well)	Date Drilling Completed: \$/19/06	1 CHIII #. 1415-GW-10027	The second contract of			
State Law requires that this report be prepared by the driller in detail and filed with the Department within 30 days of completion of drilling of the well.	State Law requires that this report be prepared by the driller in detail and filed with the Department within 30 days of completion of drilling of the well.	State Law requires that this report be prepared by the driller in detail and filed with the Department within 30 days of completion of drilling of the well.	Driller: LAYNE-CENTRAL			L. S. Elevation:	
Addys of completion of drilling of the well. Information on Well Owner (Landowner if borchole is not for a water well) Owner Name KOCH FOODS Mailing Address: 4688 HIGHWAY 80 Method of Lat/Long (circle one): City State Zip Code Telephone No. (601) 732-8911 Telephone No. (601) 732-8911 Telephone No. (601) 732-8911 Telephone No. (601) 732-8911 Well Data Purpose of Well (circle one): Home Industrial Public Supply Irrigation Date well drilling started: 2/24/06 Date well drilling completed: 5/19/06 Method of Measurement (circle one): steel tape electric tape air line Other: Type of grout (circle one): Cement Bentonite Miss Setting days of completion (circle all applicable): Gravel Packed Underreamed Telescoped or more than one screen, describe on back of page. Name of organization running log(s): LAYNE-CENTRAL, JACKSON, MS Well or Borekole is 10 a depth of Borton to ther: Well or Borton to Benton to Held Or Location Well or Borton to Benton to Held Or Location Well of Industrial USGS quad, Hand-Held GPS. Survey-grade GPS Well gericle one): Conventional Survey USGS quad, Hand-Held GPS. Survey-grade GPS Well of End Lat/Long (circle one): Conventional Survey Two of State USGS quad, Hand-Held GPS. Survey-grade GPS Survey-grade GPS Well gericle one: Conventional Survey Two of State USGS quad, Hand-Held GPS. Survey-grade GPS Survey-grade GPS Survey-grade GPS Well gericle one: Conventional Survey Two of State USGS quad, Hand-Held GPS. Survey-grade GPS Survey-grade GPS Survey-grade GPS Survey-grade GPS Well gericle one: Coherity Signal Try from SNORTH Other:	State Stat	30 days of completion of drilling of the well. Information on Well Ower (Landowner if borehole is not for a water well) Owner Name KOCH FOODS Mailing Address: 4688 HIGHWAY 80 MORTON MS 39117 City State Zip Code MORTON MS 39117 City State Zip Code Well or Borehole Location Survey-grade GPS	Date Drilling Completed: 5/19/06	,	,	E-Log #:	
Addys of completion of drilling of the well. Information on Well Owner (Landowner of borehole is not for a water well) Owner Name KOCH FOODS Mailing Address: 4688 HIGHWAY 80 Method of Lat/Long (circle one): City State Zip Code Well or Borehole Location N3.2.21382 Longitude: W089.39418 Method of Lat/Long (circle one): Conventional Survey-grade GPS Size Well of Lat/Long (circle one): USGS quad, Hand-Held GPS. Survey-grade GPS Size Well of Lat/Long (circle one): USGS quad, Hand-Held GPS. Survey-grade GPS Well Data Purpose of Well (circle one): Home Industrial Public Supply Irrigation Date well drilling completed: Static Water Level: 334 feet above or below (circle one) land surface Date Measurement (circle one): Static Water Level: 334 feet above or below (circle one) land surface Date Measurement (circle one): Static Water Level: 334 feet above or below (circle one) land surface Date Measurement (circle one): Static Water Level: 334 feet above or below (circle one) land surface Date Measured: 5/17/06 Method of Measurement (circle one): Steel tape electric tape air line Other: Type of grout (circle one): Cement Bentonite Mix Casing length: 790 feet Casing diameter: 16 inches Type of casing: COATED STEEL Screen length: 80 feet Screen diameter: 10 inches Type of screen: STAINLESS STEEL Screen length: From 800 feet to 880 feet Type of completion (circle all applicable): Gravel Packed Underreamed Telescoped or more than one screen, describe on back of page. Other (describe): Top of lap pipe or reduction in casing: 716 feet. If telescoped or more than one screen, describe on back of page. Name of organization running log(s): LAYNE-CENTRAL, JACKSON, MS	State Stat	30 days of completion of drilling of the well. Information on Well Ower (Landowner if borehole is not for a water well) Owner Name KOCH FOODS Mailing Address: 4688 HIGHWAY 80 MORTON MS 39117 City State Zip Code MORTON MS 39117 City State Zip Code Telephone No. (601) 732-8911 Well Data Purpose of Well (circle one): Home Industrial Public Supply Irrigation Fish Culture Other: Date well drilling started: 2/24/06 Date well drilling completed: 5/19/06 If flowing, method of flow regulation: Valve — Other (describe) — Static Water Level: 334 feet above or below (circle one) land surface Date Measurement (circle one) steel tape electric tape air line Other: — Hole depth: 880' Well depth: 880' Well grouted to a depth of: 790 feet Type of grout (circle one): Cement Bentonite Mix Casing length: 790 feet Casing diameter: 16 inches Type of casing: COATED STEEL Screen length: 80 feet Screen diameter: 10 inches Type of screen: STAINLESS STEEL Screen slot size: 0.020 inches Setting depth: From 800 feet to 880 feet Type of completion (circle all applicable): Gravel Packed Underreamed Telescoped Open Hole Natural Development Other (describe): — Top of lap pipe or reduction in casing: 716 feet. If telescoped or more than one screen, describe on back of page. Logs run (circle all applicable): No log run Electric Gamma Ray Density Sonic Neutron Other: — Name of organization running log(s): LAYNE-CENTRAL, JACKSON, MS Latitude: N. 32.21382 Lagitude: W 0809.9418 Method of Lat/Long (circle one): Conventional Survey Well Gircle one): Conventional Survey Well Gircle one): No log run Electric Gamma Ray Density Sonic Neutron Other: — Name of organization running log(s): LAYNE-CENTRAL, JACKSON, MS Latitude: N. 32.21382 Latitude: N. 32.2	State I am requires that this senont	ha neangead by the dei	Her in detail and filed with the	Denartment within	
Candowner if borehole is not for a water well) Candowner if borehole is not for a water well) Commer Name KOCH FOODS	Mailing Address: 4688 HIGHWAY 80	Information on Well Owner (ILandowner if borehole is not for a water well) Septender is not for a water well well and surface Septender is not for a water well) Septender is not for a water well Septender			uer in ueiuu unu jueu wan inc	Department water	
Owner Name KOCH FOODS Mailing Address: 4688 HIGHWAY 80 MORTON MS 39117 City State Zip Code Telephone No. (601) 732-8911 Well Data Purpose of Well (circle one): Home Industrial Public Supply Irrigation Fish Culture Other: Date well drilling started: 2/24/06 Date well drilling started: 2/24/06 Date well drilling started: 334 feet above or below (circle one) land surface Date Measured: 5/19/06 Method of Measurement (circle one): steel tape electric tape air line Other: Type of grout (circle one): Cement Bentonite Mix Casing length: 790 feet Casing diameter: 16 inches Type of casing: COATED STEEL Screen length: 80 feet Screen diameter: 10 inches Type of serven: STAINLESS STEEL Screen Statice: 1716 feet. Helescoped Open Hole Natural Development Other (describe): Top of lap pipe or reduction in casing: 716 feet. Helescoped or more than one screen, describe on back of page. Latitude: N 32.21382 Longitude: W 089.39418 Method of Lat/Long (circle one): Conventional Survey Workpard (Gircle one): Survey-grade GPS	Latitude: N 32.21382 Longitude: W 089.39418 Mailing Address: 4688 HIGHWAY 80	Latitude: N32.21382 Longitude: W 089.39418 Mailing Address: 4688 HIGHWAY 80 Method of Lat/Long (circle one): Conventional Survey			Well or Bor		
Mailing Address: 4688 HIGHWAY 80 MORTON MS 39117 City State Zip Code Telephone No. (601) 732-8911 Well Data Purpose of Well (circle one): Home Industrial Public Supply Irrigation Fish Culture Other: Date well drilling started: 2/24/06 Date well drilling completed: 5/19/06 If flowing, method of flow regulation: Valve — Other (describe) — Static Water Level: 334 feet above or below (circle one) land surface Date Measurement (circle one) Steel tape clectric tape air line Other: — Type of grout (circle one): Cement Bentonite Mix Casing length: 790 feet Casing diameter: 16 inches Type of casing: COATED STEEL Screen length: 80 feet Screen diameter: 10 inches Type of screen: STAINLESS STEEL Screen slot size: 0.020 inches Setting depth: From 800 feet to 880 feet Type of completion (circle all applicable): Gravel Packed Underreamed Telescoped Open Hole Natural Development Other (describe): — Top of lap pipe or reduction in casing: 716 feet. If telescoped or more than one screen, describe on back of page. Logs run (circle all applicable): No log run Electric Gamma Ray Density Sonic Neutron Other: — Name of organization running log(s): LAYNE-CENTRAL, JACKSON, MS	Mailing Address: 4688 HIGHWAY 80 Morton Ms 39117 City State Zip Code Telephone No. (601) 732-8911 Well Data Purpose of Well (circle one): Home Industrial Public Supply Irrigation Fish Culture Other: — Date well drilling started: 2/24/06 Date well drilling started: 334 feet above or below (circle one) land surface Date Measurement (circle one) Static Water Level: 334 feet above or below (circle one) land surface Date Measurement (circle one) Hole depth: 880' Well depth: 880' Well grouted to a depth of: 790 feet Type of grout (circle one): Coment Bentonite Mix Casing length: 790 feet Casing diameter: 16 inches Type of casing: COATED STEEL Screen length: 80 feet Screen diameter: 10 inches Type of screen: STAINLESS STEEL Screen slot size: 0.020 inches Setting depth: From 800 feet to 880 feet Type of completion (circle all applicable): Gravel Packed (Underreamed Telescoped Open Hole Natural Development Other: — Top of lap pipe or reduction in casing: 716 feet. If telescoped or more than one screen, describe on back of page. Logs run (circle all applicable): No log run Electric Gamma Ray Density Sonic Neutron Other: — Name of organization running log(s): LAYNE-CENTRAL, JACKSON, MS I certify that the well was drilled, constructed and completed in accordance with applicable requirements of the	Mailing Address: 4688 HIGHWAY 80 MORTON MS 39117 City State Zip Code Distance Direction Nearest Town Near	(Landowner if borehole is not for a	a water well)	32° 21' 32.	55 89°39' 25 .65"	
MORTON MS 39117 City State Zip Code City State Zip Code Distance Direction Nearest Town	MORTON MS 39117 City State Zip Code MORTON	MORTON MS 39117 City State Zip Code Direction Nearest Town 1000 FEET Mrites NORTH of HIGHWAY 80	Owner Name KOCH FOODS	Fig.	Latitude: N 32.21382	Longitude: W 089.39418	
MORTON MS 39117 City State Zip Code Distance	MORTON MS 39117 City State Zip Code Distance	MORTON MS 39117 City State Zip Code State Zip Code Distance 1000 FEET Miles NORTH of HIGHWAY 80 Nearest Town	Mailing Address: 4688 HIGHWAY 80		Method of Lat/Long (circle one)	: Conventional Survey	
MORTON City State Zip Code Distance Noarth Of HIGHWAY 80 Nearest Town Near	City State Zip Code Distance Direction Nearest Town	MORTON City State Zip Code Distance Direction Distance Direction Nearest Town Neare		4	1	GPS, Survey-grade GPS	
Telephone No. (601) 732-8911 Well Data Purpose of Well (circle one): Home Industrial Public Supply Irrigation Fish Culture Other: Date well drilling started:	Telephone No. (601) 732-8911 Distance Direction Nearest Town	Telephone No. (601) 732-8911 Distance Direction Nearest Town	MORTON	MS 39117	NE 1/4 NW 1/4 Sec 23	Twn 6N Rng 6E	
Telephone No. (601) 732-8911	Telephone No. (601) 732-8911 Telephone No. (601) 744-6 T	Telephone No. (601) 732-8911	City	State Zip Code	Distance Directi	on Nearest Town	
Purpose of Well (circle one): Home Industrial Public Supply Irrigation Fish Culture Other: Date well drilling started: 2/24/06 Date well drilling completed: 5/19/06 If flowing, method of flow regulation: Valve - Other (describe) Static Water Level: 334 feet above or below (circle one) land surface Date Measured: 5/17/06 Method of Measurement (circle one) steel tape electric tape air line Other: Hole depth: 880' Well depth: 880' Well grouted to a depth of: 790 feet Type of grout (circle one): Cement Bentonite Mix Casing length: 790 feet Casing diameter: 16 inches Type of screen: STAINLESS STEEL Screen length: 80 feet Screen diameter: 10 inches Type of screen: STAINLESS STEEL Screen slot size: 0.020 inches Setting depth: From 800 feet to 880 feet Type of completion (circle all applicable): Gravel Packed Underreamed Telescoped Open Hole Natural Development Other (describe): Top of lap pipe or reduction in casing: 716 feet. If telescoped or more than one screen, describe on back of page. Logs run (circle all applicable): No log run Electric Gamma Ray Density Sonic Neutron Other: Name of organization running log(s): LAYNE-CENTRAL, JACKSON, MS	Purpose of Well (circle one): Home Industrial Public Supply Irrigation Fish Culture Other: — Date well drilling started: 2/24/06 Date well drilling completed: 5/19/06 If flowing, method of flow regulation: Valve — Other (describe) — Static Water Level: 334 feet above or below (circle one) land surface Date Measured: 5/17/06 Method of Measurement (circle one) steel tape electric tape air line Other: — Hole depth: 880' Well grouted to a depth of: 790 feet Type of grout (circle one): Cement Bentonite Mix Casing length: 790 feet Casing diameter: 16 inches Type of casing: COATED STEEL Screen length: 80 feet Screen diameter: 10 inches Type of screen: STAINLESS STEEL Screen slot size: 0.020 inches Setting depth: From 800 feet to 880 feet Type of completion (circle all applicable): Gravel Packed Underreamed Telescoped Open Hole Natural Development Other (describe): — Top of lap pipe or reduction in casing: 716 feet. If telescoped or more than one screen, describe on back of page. Logs run (circle all applicable): No log run Electric Gamma Ray Density Sonic Neutron Other: — Name of organization running log(s): LAYNE-CENTRAL, JACKSON, MS I certify that the well was drilled, constructed and completed in accordance with applicable requirements of the	Purpose of Well (circle one): Home Industrial Public Supply Irrigation Fish Culture Other: Date well drilling started: 2/24/06 Date well drilling completed: 5/19/06 If flowing, method of flow regulation: Valve — Other (describe) — Static Water Level: 334 feet above or below (circle one) land surface Date Measured: 5/17/06 Method of Measurement (circle one) steel tape electric tape air line Other: ———————————————————————————————————	Telephone No. (601) 732-8911				
Purpose of Well (circle one): Home Industrial Public Supply Irrigation Fish Culture Other:	Purpose of Well (circle one): Home Industrial Public Supply Irrigation Fish Culture Other:	Purpose of Well (circle one): Home Industrial Public Supply Irrigation Fish Culture Other:					
Date well drilling started: 2/24/06 Date well drilling completed: 5/19/06 If flowing, method of flow regulation: Valve Other (describe) Static Water Level: 334 feet above or below (circle one) land surface Method of Measurement (circle one) Steel tape electric tape air line Other:	Date well drilling started: 2/24/06 Date well drilling completed: 5/19/06 If flowing, method of flow regulation: Valve — Other (describe) — Static Water Level: 334 feet above or below (circle one) land surface Date Measured: 5/17/06 Method of Measurement (circle one) steel tape electric tape air line Other: —— Hole depth: 880' Well depth: 880' Well grouted to a depth of: 790 feet Type of grout (circle one): Cement Bentonite Mix Casing length: 790 feet Casing diameter: 16 inches Type of casing: COATED STEEL Screen length: 80 feet Screen diameter: 10 inches Type of screen: STAINLESS STEEL Screen slot size: 0.020 inches Setting depth: From 800 feet to 880 feet Type of completion (circle all applicable): Gravel Packed Underreamed Telescoped Open Hole Natural Development Other (describe): — Top of lap pipe or reduction in casing: 716 feet. If telescoped or more than one screen, describe on back of page. Logs run (circle all applicable): No log run Electric Gamma Ray Density Sonic Neutron Other: — Name of organization running log(s): LAYNE-CENTRAL, JACKSON, MS I certify that the well was drilled, constructed and completed in accordance with applicable requirements of the	Date well drilling started: 2/24/06 Date well drilling completed: 5/19/06 If flowing, method of flow regulation: Valve Other (describe) Static Water Level: 334 feet above or below (circle one) land surface Date Measured: 5/17/06 Method of Measurement (circle one) Steel tape electric tape air line Other: Hole depth: 880' Well grouted to a depth of: 790 feet Type of grout (circle one): Cement Bentonite Mix Casing length: 790 feet Casing diameter: 16 inches Type of casing: COATED STEEL Screen length: 80 feet Screen diameter: 10 inches Type of screen: STAINLESS STEEL Screen slot size: 0.020 inches Setting depth: From 800 feet Type of completion (circle all applicable): Gravel Packed Underreamed Other (describe): Top of lap pipe or reduction in casing: 716 feet. If telescoped or more than one screen, describe on back of page. Logs run (circle all applicable): No log run Electric Gamma Ray Density Sonic Neutron Other: - Name of organization running log(s): LAYNE-CENTRAL, JACKSON, MS DAVE COOK 692					
If flowing, method of flow regulation: Valve — Other (describe) — Static Water Level: 334 feet above or below (circle one) land surface Date Measured: 5/17/06 Method of Measurement (circle one) steel tape electric tape air line Other: — Hole depth: 880' Well grouted to a depth of: 790 feet Type of grout (circle one): Cement Bentonite Mix Casing length: 790 feet Casing diameter: 16 inches Type of casing: COATED STEEL Screen length: 80 feet Screen diameter: 10 inches Type of screen: STAINLESS STEEL Screen slot size: 0.020 inches Setting depth: From 800 feet to 880 feet Type of completion (circle all applicable): Gravel Packed Underreamed Telescoped Open Hole Natural Development Other (describe): — Top of lap pipe or reduction in casing: 716 feet. If telescoped or more than one screen, describe on back of page. Logs run (circle all applicable): No log run Electric Gamma Ray Density Sonic Neutron Other: — Name of organization running log(s): LAYNE-CENTRAL, JACKSON, MS	If flowing, method of flow regulation: Valve — Other (describe) — Static Water Level: 334 feet above or below (circle one) land surface Date Measured: 5/17/06 Method of Measurement (circle one) steel tape electric tape air line Other: — Hole depth: 880' Well depth: 880' Well grouted to a depth of: 790 feet Type of grout (circle one): Cement Bentonite Mix Casing length: 790 feet Casing diameter: 16 inches Type of casing: COATED STEEL Screen length: 80 feet Screen diameter: 10 inches Type of screen: STAINLESS STEEL Screen slot size: 0.020 inches Setting depth: From 800 feet to 880 feet Type of completion (circle all applicable): Gravel Packed Underreamed Telescoped Open Hole Natural Development Other (describe): — Top of lap pipe or reduction in casing: 716 feet. If telescoped or more than one screen, describe on back of page. Logs run (circle all applicable): No log run Electric Gamma Ray Density Sonic Neutron Other: — Name of organization running log(s): LAYNE-CENTRAL, JACKSON, MS I certify that the well was drilled, constructed and completed in accordance with applicable requirements of the	If flowing, method of flow regulation: Valve Other (describe)	Purpose of Well (circle one): Home In	ndustrial Public Sup	oply Irrigation Fish Cul	ture Other:	
Static Water Level: 334 feet above or below (circle one) land surface Date Measured: 5/17/06 Method of Measurement (circle one) steel tape electric tape air line Other: Hole depth: 880' Well grouted to a depth of: 790 feet Type of grout (circle one): Cement Bentonite Mix Casing length: 790 feet Casing diameter: 16 inches Type of casing: COATED STEEL Screen length: 80 feet Screen diameter: 10 inches Type of screen: STAINLESS STEEL Screen slot size: 0.020 inches Setting depth: From 800 feet to 880 feet Type of completion (circle all applicable): Gravel Packed Underreamed Telescoped Open Hole Natural Development Other (describe): Top of lap pipe or reduction in casing: 716 feet. If telescoped or more than one screen, describe on back of page. Logs run (circle all applicable): No log run Electric Gamma Ray Density Sonic Neutron Other: Name of organization running log(s): LAYNE-CENTRAL, JACKSON, MS	Static Water Level: 334 feet above or below (circle one) land surface Date Measured: 5/17/06 Method of Measurement (circle one) steel tape electric tape air line Other: — Hole depth: 880' Well depth: 880' Well grouted to a depth of: 790 feet Type of grout (circle one): Cement Bentonite Mix Casing length: 790 feet Casing diameter: 16 inches Type of casing: COATED STEEL Screen length: 80 feet Screen diameter: 10 inches Type of screen: STAINLESS STEEL Screen slot size: 0.020 inches Setting depth: From 800 feet to 880 feet Type of completion (circle all applicable): Gravel Packed Underreamed Telescoped Open Hole Natural Development Other (describe): — Top of lap pipe or reduction in casing: 716 feet. If telescoped or more than one screen, describe on back of page. Logs run (circle all applicable): No log run Electric Gamma Ray Density Sonic Neutron Other: — Name of organization running log(s): LAYNE-CENTRAL, JACKSON, MS I certify that the well was drilled, constructed and completed in accordance with applicable requirements of the	Static Water Level: 334 feet above or below (circle one) land surface Date Measured: 5/17/06 Method of Measurement (circle one) steel tape electric tape air line Other: — Hole depth: 880' Well depth: 880' Well grouted to a depth of: 790 feet Type of grout (circle one): Cement Bentonite Mix Casing length: 790 feet Casing diameter: 16 inches Type of casing: COATED STEEL Screen length: 80 feet Screen diameter: 10 inches Type of screen: STAINLESS STEEL Screen slot size: 0.020 inches Setting depth: From 800 feet to 880 feet Type of completion (circle all applicable): Gravel Packed Underreamed Telescoped Open Hole Natural Development Other (describe): — Top of lap pipe or reduction in casing: 716 feet. If telescoped or more than one screen, describe on back of page. Logs run (circle all applicable): No log run Electric Gamma Ray Density Sonic Neutron Other: — Name of organization running log(s): LAYNE-CENTRAL, JACKSON, MS I certify that the well was drilled, constructed and completed in accordance with applicable requirements of the Mississippi Department of Environmental Quality and the Mississippi Department of Health regulations and state laws. DAVE COOK 692	Date well drilling started: 2/2	24/06	Date well drilling complete	ed: 5/19/06	
Method of Measurement (circle one) steel tape electric tape air line Other: ————————————————————————————————————	Method of Measurement (circle one) steel tape electric tape air line Other:	Method of Measurement (circle one) steel tape electric tape air line Other:	If flowing, method of flow regulation:	Valve	Other (describe)		
Hole depth: 880' Well depth: 880' Well grouted to a depth of: 790 feet Type of grout (circle one): Cement Bentonite Mix Casing length: 790 feet Casing diameter: 16 inches Type of casing: COATED STEEL Screen length: 80 feet Screen diameter: 10 inches Type of screen: STAINLESS STEEL Screen slot size: 0.020 inches Setting depth: From 800 feet to 880 feet Type of completion (circle all applicable): Gravel Packed Underreamed Telescoped Open Hole Natural Development Other (describe): Top of lap pipe or reduction in casing: 716 feet. If telescoped or more than one screen, describe on back of page. Logs run (circle all applicable): No log run Electric Gamma Ray Density Sonic Neutron Other: Name of organization running log(s): LAYNE-CENTRAL, JACKSON, MS	Hole depth: 880' Well depth: 880' Well grouted to a depth of: 790 feet Type of grout (circle one): Cement Bentonite Mix Casing length: 790 feet Casing diameter: 16 inches Type of casing: COATED STEEL Screen length: 80 feet Screen diameter: 10 inches Type of screen: STAINLESS STEEL Screen slot size: 0.020 inches Setting depth: From 800 feet to 880 feet Type of completion (circle all applicable): Gravel Packed Underreamed Telescoped Open Hole Natural Development Other (describe): Top of lap pipe or reduction in casing: 716 feet. If telescoped or more than one screen, describe on back of page. Logs run (circle all applicable): No log run Electric Gamma Ray Density Sonic Neutron Other: Name of organization running log(s): LAYNE-CENTRAL, JACKSON, MS I certify that the well was drilled, constructed and completed in accordance with applicable requirements of the	Hole depth: 880' Well depth: 880' Well grouted to a depth of: 790 feet Type of grout (circle one): Cement Bentonite Mix Casing length: 790 feet Casing diameter: 16 inches Type of casing: COATED STEEL Screen length: 80 feet Screen diameter: 10 inches Type of screen: STAINLESS STEEL Screen slot size: 0.020 inches Setting depth: From 800 feet to 880 feet Type of completion (circle all applicable): Gravel Packed Underreamed Telescoped Open Hole Natural Development Other (describe): Top of lap pipe or reduction in casing: 716 feet. If telescoped or more than one screen, describe on back of page. Logs run (circle all applicable): No log run Electric Gamma Ray Density Sonic Neutron Other: Name of organization running log(s): LAYNE-CENTRAL, JACKSON, MS I certify that the well was drilled, constructed and completed in accordance with applicable requirements of the Mississippi Department of Environmental Quality and the Mississippi Department of Health regulations and state laws. DAVE COOK 692	Static Water Level: 334 feet ab	ove or below (circ	ele one) land surface Date	Measured: 5/17/06	
Type of grout (circle one): Cement Bentonite Mix Casing length: 790 feet Casing diameter: 16 inches Type of casing: COATED STEEL Screen length: 80 feet Screen diameter: 10 inches Type of screen: STAINLESS STEEL Screen slot size: 0.020 inches Setting depth: From 800 feet to 880 feet Type of completion (circle all applicable): Gravel Packed Underreamed Telescoped Open Hole Natural Development Other (describe): Top of lap pipe or reduction in casing: 716 feet. If telescoped or more than one screen, describe on back of page. Logs run (circle all applicable): No log run Electric Gamma Ray Density Sonic Neutron Other: Name of organization running log(s): LAYNE-CENTRAL, JACKSON, MS	Type of grout (circle one): Casing length: 790 feet Casing diameter: 16 inches Type of casing: COATED STEEL Screen length: 80 feet Screen diameter: 10 inches Type of screen: STAINLESS STEEL Screen slot size: 0.020 inches Setting depth: From 800 feet to 880 feet Type of completion (circle all applicable): Gravel Packed Underreamed Telescoped Open Hole Natural Development Other (describe): Top of lap pipe or reduction in casing: 716 feet. If telescoped or more than one screen, describe on back of page. Logs run (circle all applicable): No log run Electric Gamma Ray Density Sonic Neutron Other: Name of organization running log(s): LAYNE-CENTRAL, JACKSON, MS I certify that the well was drilled, constructed and completed in accordance with applicable requirements of the	Type of grout (circle one): Cement Bentonite Mix Casing length: 790 feet Casing diameter: 16 inches Type of casing: COATED STEEL Screen length: 80 feet Screen diameter: 10 inches Type of screen: STAINLESS STEEL Screen slot size: 0.020 inches Setting depth: From 800 feet to 880 feet Type of completion (circle all applicable): Gravel Packed Underreamed Telescoped Open Hole Natural Development Other (describe): Top of lap pipe or reduction in casing: 716 feet. If telescoped or more than one screen, describe on back of page. Logs run (circle all applicable): No log run Electric Gamma Ray Density Sonic Neutron Other: Name of organization running log(s): LAYNE-CENTRAL, JACKSON, MS I certify that the well was drilled, constructed and completed in accordance with applicable requirements of the Mississippi Department of Environmental Quality and the Mississippi Department of Health regulations and state laws. DAVE COOK 692	Method of Measurement (circle one)	steel tape elec	etric tape air line Othe	er:	
Casing length: 790 feet Casing diameter: 16 inches Type of casing: COATED STEEL Screen length: 80 feet Screen diameter: 10 inches Type of screen: STAINLESS STEEL Screen slot size: 0.020 inches Setting depth: From 800 feet to 880 feet Type of completion (circle all applicable): Gravel Packed Underreamed Telescoped Open Hole Natural Development Other (describe): Top of lap pipe or reduction in casing: 716 feet. If telescoped or more than one screen, describe on back of page. Logs run (circle all applicable): No log run Electric Gamma Ray Density Sonic Neutron Other: Name of organization running log(s): LAYNE-CENTRAL, JACKSON, MS	Casing length: 790 feet Casing diameter: 16 inches Type of casing: COATED STEEL Screen length: 80 feet Screen diameter: 10 inches Type of screen: STAINLESS STEEL Screen slot size: 0.020 inches Setting depth: From 800 feet to 880 feet Type of completion (circle all applicable): Gravel Packed Underreamed Telescoped Open Hole Natural Development Other (describe): Top of lap pipe or reduction in casing: 716 feet. If telescoped or more than one screen, describe on back of page. Logs run (circle all applicable): No log run Electric Gamma Ray Density Sonic Neutron Other: Name of organization running log(s): LAYNE-CENTRAL, JACKSON, MS I certify that the well was drilled, constructed and completed in accordance with applicable requirements of the	Casing length: 790 feet Casing diameter: 16 inches Type of casing: COATED STEEL Screen length: 80 feet Screen diameter: 10 inches Type of screen: STAINLESS STEEL Screen slot size: 0.020 inches Setting depth: From 800 feet to 880 feet Type of completion (circle all applicable): Gravel Packed Underreamed Telescoped Open Hole Natural Development Other (describe): Top of lap pipe or reduction in casing: 716 feet. If telescoped or more than one screen, describe on back of page. Logs run (circle all applicable): No log run Electric Gamma Ray Density Sonic Neutron Other: Name of organization running log(s): LAYNE-CENTRAL, JACKSON, MS I certify that the well was drilled, constructed and completed in accordance with applicable requirements of the Mississippi Department of Environmental Quality and the Mississippi Department of Health regulations and state laws. DAVE COOK 692	Hole depth: 880' W	ell depth: 880'	Well grouted to a dept	th of: 790 feet	
Screen length: 80 feet Screen diameter: 10 inches Type of screen: STAINLESS STEEL Screen slot size: 0.020 inches Setting depth: From 800 feet to 880 feet Type of completion (circle all applicable): Gravel Packed Underreamed Telescoped Open Hole Natural Development Other (describe): — Top of lap pipe or reduction in casing: 716 feet. If telescoped or more than one screen, describe on back of page. Logs run (circle all applicable): No log run Electric Gamma Ray Density Sonic Neutron Other: — Name of organization running log(s): LAYNE-CENTRAL, JACKSON, MS	Screen length: 80 feet Screen diameter: 10 inches Type of screen: STAINLESS STEEL Screen slot size: 0.020 inches Setting depth: From 800 feet to 880 feet Type of completion (circle all applicable): Gravel Packed Underreamed Telescoped Open Hole Natural Development Other (describe): Top of lap pipe or reduction in casing: 716 feet. If telescoped or more than one screen, describe on back of page. Logs run (circle all applicable): No log run Electric Gamma Ray Density Sonic Neutron Other: Name of organization running log(s): LAYNE-CENTRAL, JACKSON, MS I certify that the well was drilled, constructed and completed in accordance with applicable requirements of the	Screen length: 80 feet Screen diameter: 10 inches Type of screen: STAINLESS STEEL Screen slot size: 0.020 inches Setting depth: From 800 feet to 880 feet Type of completion (circle all applicable): Gravel Packed Underreamed Telescoped Open Hole Natural Development Other (describe): — Top of lap pipe or reduction in casing: 716 feet. If telescoped or more than one screen, describe on back of page. Logs run (circle all applicable): No log run Electric Gamma Ray Density Sonic Neutron Other: — Name of organization running log(s): LAYNE-CENTRAL, JACKSON, MS I certify that the well was drilled, constructed and completed in accordance with applicable requirements of the Mississippi Department of Environmental Quality and the Mississippi Department of Health regulations and state laws. DAVE COOK 692	Type of grout (circle one): Cement Bentonite Mix				
Screen slot size: 0.020 inches Setting depth: From 800 feet to 880 feet Type of completion (circle all applicable): Gravel Packed Underreamed Telescoped Open Hole Natural Development Other (describe): Top of lap pipe or reduction in casing: 716 feet. If telescoped or more than one screen, describe on back of page. Logs run (circle all applicable): No log run Electric Gamma Ray Density Sonic Neutron Other: Name of organization running log(s): LAYNE-CENTRAL, JACKSON, MS	Screen slot size: 0.020 inches Setting depth: From 800 feet to 880 feet Type of completion (circle all applicable): Gravel Packed Underreamed Telescoped Open Hole Natural Development Other (describe): Top of lap pipe or reduction in casing: 716 feet. If telescoped or more than one screen, describe on back of page. Logs run (circle all applicable): No log run Electric Gamma Ray Density Sonic Neutron Other: Name of organization running log(s): LAYNE-CENTRAL, JACKSON, MS I certify that the well was drilled, constructed and completed in accordance with applicable requirements of the	Screen slot size: 0.020 inches Setting depth: From 800 feet to 880 feet Type of completion (circle all applicable): Gravel Packed Underreamed Telescoped Open Hole Natural Development Other (describe): Top of lap pipe or reduction in casing: 716 feet. If telescoped or more than one screen, describe on back of page. Logs run (circle all applicable): No log run Electric Gamma Ray Density Sonic Neutron Other: Name of organization running log(s): LAYNE-CENTRAL, JACKSON, MS I certify that the well was drilled, constructed and completed in accordance with applicable requirements of the Mississippi Department of Environmental Quality and the Mississippi Department of Health regulations and state laws. DAVE COOK 692	Casing length: 790 feet	Casing diameter:	16 inches Type of	casing: COATED STEEL	
Type of completion (circle all applicable): Gravel Packed Underreamed Telescoped Open Hole Natural Development Other (describe): Top of lap pipe or reduction in casing: 716 feet. If telescoped or more than one screen, describe on back of page. Logs run (circle all applicable): No log run Electric Gamma Ray Density Sonic Neutron Other: Name of organization running log(s): LAYNE-CENTRAL, JACKSON, MS	Type of completion (circle all applicable): Gravel Packed Underreamed Telescoped Open Hole Natural Development Other (describe): Top of lap pipe or reduction in casing:	Type of completion (circle all applicable): Gravel Packed Underreamed Telescoped Open Hole Natural Development Other (describe): — Top of lap pipe or reduction in casing: 716 feet. If telescoped or more than one screen, describe on back of page. Logs run (circle all applicable): No log run Electric Gamma Ray Density Sonic Neutron Other: — Name of organization running log(s): LAYNE-CENTRAL, JACKSON, MS I certify that the well was drilled, constructed and completed in accordance with applicable requirements of the Mississippi Department of Environmental Quality and the Mississippi Department of Health regulations and state laws. DAVE COOK 692	Screen length: 80 feet	Screen diameter:	10 inches Type of	screen: STAINLESS STEEL	
Other (describe): Top of lap pipe or reduction in casing:	Other (describe): Top of lap pipe or reduction in casing:	Other (describe): Top of lap pipe or reduction in casing: 716 feet. If telescoped or more than one screen, describe on back of page. Logs run (circle all applicable): No log run Electric Gamma Ray Density Sonic Neutron Other: Name of organization running log(s): LAYNE-CENTRAL, JACKSON, MS I certify that the well was drilled, constructed and completed in accordance with applicable requirements of the Mississippi Department of Environmental Quality and the Mississippi Department of Health regulations and state laws. DAVE COOK 692	Screen slot size: 0.020 inches	Se	etting depth: From 800	feet to 880 feet	
Top of lap pipe or reduction in casing: 716 feet. If telescoped or more than one screen, describe on back of page. Logs run (circle all applicable): No log run Electric Gamma Ray Density Sonic Neutron Other: Name of organization running log(s): LAYNE-CENTRAL, JACKSON, MS	Top of lap pipe or reduction in casing: 716 feet. If telescoped or more than one screen, describe on back of page. Logs run (circle all applicable): No log run Electric Gamma Ray Density Sonic Neutron Other: Name of organization running log(s): LAYNE-CENTRAL, JACKSON, MS I certify that the well was drilled, constructed and completed in accordance with applicable requirements of the	Top of lap pipe or reduction in casing: 716 feet. If telescoped or more than one screen, describe on back of page. Logs run (circle all applicable): No log run Electric Gamma Ray Density Sonic Neutron Other:	Type of completion (circle all applicable): Gravel Packed Underreamed Telescoped Open Hole Natural Development				
Logs run (circle all applicable): No log run Electric Gamma Ray Density Sonic Neutron Other:	Logs run (circle all applicable): No log run Electric Gamma Ray Density Sonic Neutron Other: Name of organization running log(s): LAYNE-CENTRAL, JACKSON, MS I certify that the well was drilled, constructed and completed in accordance with applicable requirements of the	Logs run (circle all applicable): No log run Electric Gamma Ray Density Sonic Neutron Other:	3. 36.	Other (describe):	-		
Name of organization running log(s): LAYNE-CENTRAL, JACKSON, MS	Name of organization running log(s): LAYNE-CENTRAL, JACKSON, MS I certify that the well was drilled, constructed and completed in accordance with applicable requirements of the	Name of organization running log(s): LAYNE-CENTRAL, JACKSON, MS I certify that the well was drilled, constructed and completed in accordance with applicable requirements of the Mississippi Department of Environmental Quality and the Mississippi Department of Health regulations and state laws. DAVE COOK 692	Top of lap pipe or reduction in casing:	716 feet.	If telescoped or more than one so	creen, describe on back of page.	
	I certify that the well was drilled, constructed and completed in accordance with applicable requirements of the	I certify that the well was drilled, constructed and completed in accordance with applicable requirements of the Mississippi Department of Environmental Quality and the Mississippi Department of Health regulations and state laws. DAVE COOK 692	Logs run (circle all applicable): No log r	un Electric Gamma	a Ray Density Sonic Neutro	n Other: -	
	I certify that the well was drilled, constructed and completed in accordance with applicable requirements of the	I certify that the well was drilled, constructed and completed in accordance with applicable requirements of the Mississippi Department of Environmental Quality and the Mississippi Department of Health regulations and state laws. DAVE COOK 692				- 2	
I south that the well was drilled constructed and completed in accordance with applicable recommends of the		Mississippi Department of Environmental Quality and the Mississippi Department of Health regulations and state laws. DAVE COOK 692					
	Mississippi Department of Environmental Quality and the Mississippi Department of Health regulations and state laws.	DAVE COOK 692 Dive John					
Mississippi Department of Environmental Quality and the Mississippi Department of Health regulations and state laws.			Mississippi Department of Environmental	Quality and the Missis	sippi Department of Health regu	niations and state laws.	
	DAVE COOK 692		DAVE COOK	602	6)2.	· lale	
DAVE COOK 602		THE Paris of Water well contractor and License No.	Print Name of Water Well Contractor and L		Signature	of Water Well Contractor	

RECEIVED SEP 1 1 2006 BY: OLWR

Ground Level	Description of Formations Encountered	From	To
	TOP SOIL	0	5

Description of Formations Encountered	FIOII	10
TOP SOIL	0	5
YELLOW CLAY	5	20
BLUE CLAY	20	291
ROCK	291	292
SHALE & SAND STREAKS	292	460
SAND & SHALE STREAKS	460	512
SHALE & SAND STREAKS	512	565
SHALE	565	615
SANDY SHALE & ROCK STREAKS	615	690
FINE SAND & SHALE STREAKS	690	813
SAND & SHALE STREAKS	813	890
COARSE SAND (LIGNITE - SOFT)	890	942
BROWN CLAY & SHALE	942	964

If more than one screen, show location of each on sketch.

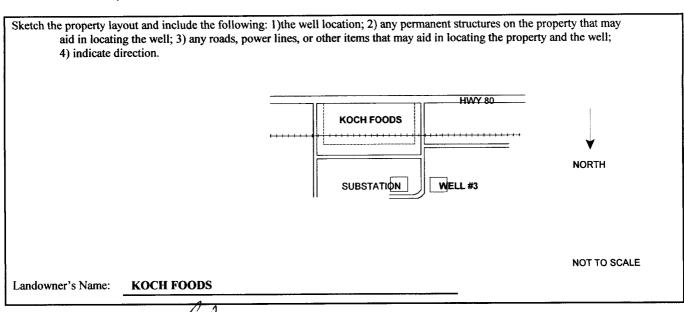

Signature of Water Well Contractor

State Well Report

		· · · · · · · · · · · · · · · · · · ·		
Country	I	Part 2	For Office Use Only:	
County: SCOTT		r's Completion Report ent of Environmental Quality	v	
Permit #: MS-GW-16027		and Water Resources	Aquifer:	
•		. Box 10631	TIMU	
Driller: LAYNE-CENTRAL		MS 39289-0631	Well#: 3-97-18	
Date Completed: 5/19/06		1) 961-5210 354-6938 (fax)	Elevation:	
		75 1 0750 (Idik)	Dievation.	
installation of pump. A copy of	Part 1 of this report must be at	tached to this report.	Department within 30 days of the	
Well Owner In	formation	32°21′323,	ell Location 89°39' 25.05	
Owner Name KOCH FOODS		Latitude: N 32.21382	Longitude: W 089.39418	
Mailing Address: 4688 HIGHWA	Y 80	Method of Lat/Long (check of	one): Conventional Survey	
		USGS quad 🗸 Hand-H	eld GPS Survey-grade GPS	
MORTON	MS 39117	NJE 1/4 NW 1/4 Sec _	23 T 6N R 6E	
City	State Zip Code	<u>5E</u> <u>5w</u>	14	
		Distance Dire	ection Nearest Town	
Telephone No. (601) 732-89	11	1000 FEET Miles NO	ORTH of HIGHWAY 80	
		<u> </u>		
Pump T	уре	P	ower Type	
Circle C	ne	(Circle One	
Air Lift Jet	Submersible	Diesel Engine Gas	soline Engine Natural Gas	
Bucket Pistor	Turbine	Electric Motor	Hand Tractor PTO	
Centrifugal Rotary	Flowing Well	Windmill	Other (specify):	
Other (specify): OIL LUBE Horse Power Rating of Motor: 200				
Date Pump Installed: 7/25/06 Setting Depth: 460 feet				
Rated Pump Capacity 101:	Gallons Per Minute	Number of Stages:	9	
		I		
Pump Test Data Method of Measuring Water Level Circle One				
Date Well Tested: 8/9	0/06		Measuring Line Steel Tape	
			Weasuring Line Steel Tape	
Static Water Level (A): 340	Feet Below Land Surface	Other (specify):		
Pumping Water Level (B): 401	Feet Below Land Surface	D 0	,	
Drawdown [(B) - (A)]:61	Feet Below Land Surface	For flowing well, measured s	-	
Test Pumping Rate: 1013	Gallons Per Minute	Well yielded 1013	GPM with a drawdown of	
Duration of Pump Test (minimum 4	hours): 8 hours	feet after	8 hours of pumping	
I hereby certify that the above statements are true to the best of my knowledge.				
DAVE COOK 602				
DAVE COOK 692 Print Name of Pump Installer and License No. (if applicable) Signature of Pump Installer				
Print Name of Pump Installer and License No. (if applicable) Signature of Pump Installer				

RECEIVED

MAR 1 9 2007

BY: OLWR