

SCOTT MISSISSIPPI BOARD OF WATER COMMISSIONERS

5 JKI T
6-27-63 WATER WELL DRILLERS LOG

Date: 6/27, 1963, Driller: Frank D. G. Sec County Scott
 (Name)

(1) Owner of Land: Junior Cook
 (Name)
Newton, Miss
 (Address)

(2) Location: 1/4, 1/4, Sec. 31 6N7E T. R.
2 1/2 miles Southwest of Newton
 (distance) (direction) (Nearest Town)

(3) Topography: X
 (Hilly) (Flat) (Level)

(4) Purpose of Well: 4 Homes
 (Domestic Irrigation
 Municipal, Industrial, Other)

Description & Color of Materials Sand, Clay, Red Clay, Shell, etc.	Thick- ness Feet	Depth Feet
<u>Chalky Clay</u>	<u>0</u>	<u>22</u>
<u>Blue Clay</u>		<u>205</u>
<u>Light Lime Rock</u>		<u>308</u>
<u>Soft Shale</u>		<u>354</u>
<u>Medium Sand</u>		<u>388</u>
<u>Fine Sand</u>		<u>415</u>

Information upon completion of well:

(1) Diameter 2" inches.

(2) Total Depth 415 feet.

(3) Water Level 168 feet below top of ground.

(4) Cased to 400, Size 2"


(5) Screen: Size 2", Length 15ft.

(6) Were any formations sealed against pollution?
yes, X no.

If YES depth of formation _____

Why _____

Drillers Remarks: _____

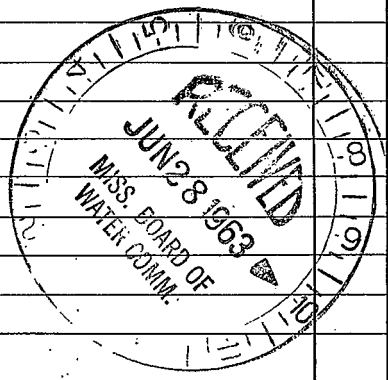

(Use Back Side)

Well No.

