

Scott  
K2  
2-68

MISSISSIPPI  
BOARD OF WATER COMMISSIONERS  
416 North State Street  
Jackson, Mississippi 39201

WATER WELL DRILLERS LOG

date well completed Feb 19 68 firm name Wilkeson Drilling Service county well located SCOTT

LANDOWNER: Jack Taylor  
221 E Taylor Dr  
Monticello, Miss  
(mailing address)


WELL LOCATION:  
sec. 32 T 6 N R 7 E  
S W  
6 miles South of Monticello  
(distance) (direction) (nearest town)

WELL PURPOSE: home  
(home, irrigation, municipal, industrial)

WELL COMPLETION DATA:

- (1) diameter (inches) 2
- (2) total depth (feet) 535
- (3) static water level (feet) 197 <sup>below</sup>/<sub>above</sub> top of ground.
- (4) casing GALV., 525,  
(material) (depth)  
2"  
(size) if telescope see back.
- (5) screen 10, 525  
(length) (depth to top)  
2, STAINLESS STEEL  
(size) (material)
- (6) pump 3, 12  
(HP) (yield gpm)  
Elec  
(type power)
- (7) electric log NO  
(yes or no)  
(organization running log)
- (8) how well bottom plugged 2" B.W.U.


description of formations encountered	from	to
Sur Face SAND	0	20
yellow CLAY	20	40
blue clay	40	80
Rock	80	82
blue u	82	103
CLAY + Rock	103	120
blue shale	120	360
lime + shale	360	400
Green Sand	400	410
brown shale sand	410	500
<del>blue</del> FINE SAND	500	515
Good SAND	515	535
SAND + shale	535	580

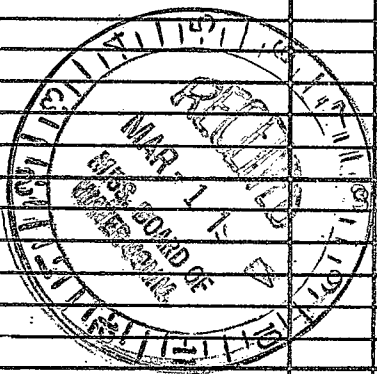

DRILLERS REMARKS:

If well telescopes please sketch and show depths.

GROUND LEVEL

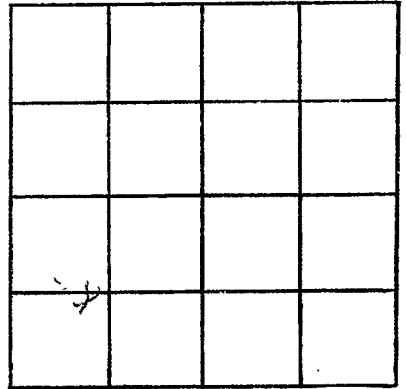

SECTION 32

Please indicate well location X.

ADDITIONAL INFORMATION

If more than one screen, show locations of each on sketch.