

WATER WELL DRILLERS LOG

Date: 8/4, 1964, Driller: Forest Drilling County: Scott
 (Name)

(1) Owner of Land: Rendering Plant
 (Name)
Forest Miss.
 (Address)

(2) Location: 1/4, 1/4, Sec. 12 T. 12 R. 12
4 miles West of Forest
 (distance) (direction) (Nearest Town)

(3) Topography: (Hilly) (Flat) (Level)

(4) Purpose of Well: Plant
 (Domestic Irrigation, Municipal, Industrial, Other)

Description & Color of Materials Sand, Clay, Red Clay, Shell, etc.	Thick-ness Feet	Depth Feet
<u>Cherty + yellow clay</u>		<u>28</u>
<u>Blue Clay</u>		<u>143</u>
<u>Rock</u>		<u>145</u>
<u>Shale + Lime Rock</u>		<u>184</u>
<u>Blue Clay</u>		<u>210</u>
<u>Shale + Sh. Rock</u>		<u>220</u>
<u>Shale</u>		<u>246</u>
<u>Shale + Soft Clay</u>		<u>350</u>
<u>Fine Sand</u>		<u>390</u>
<u>Brown Shale</u>		<u>435</u>
<u>Sand + Sh. Rock</u>		<u>450</u>
<u>Fine Sand</u>		<u>455</u>
<u>Shale (brown)</u>		<u>507</u>
<u>Rock</u>		<u>549</u>
<u>Shale</u>		<u>554</u>
<u>Shale + Sh. Rock</u>		<u>574</u>
<u>Shale + Sh. Silt</u>		<u>596</u>
<u>Shale, Lignite + Silt</u>		<u>659</u>
<u>Shale</u>		<u>668</u>
<u>Sand + Sh. Shale</u>		<u>685</u>
<u>Shale</u>		<u>695</u>
<u>Sand + Sh. Shale</u>		<u>701</u>
<u>Shale + Silt</u>		<u>711</u>
<u>Shale + Silt</u>		<u>786</u>

Information upon completion of well:

(1) Diameter: 4" x 2 1/2" inches.

(2) Total Depth: 786 feet.

(3) Water Level: 235 feet below top of ground.
336 ft 4"

(4) Cased to: 420 ft, Size: 2 1/2"


(5) Screen: Size 4", Length 30 ft

(6) Were any formations sealed against pollution?
 yes, no.

If YES depth of formation _____

Why _____

Drillers Remarks: _____

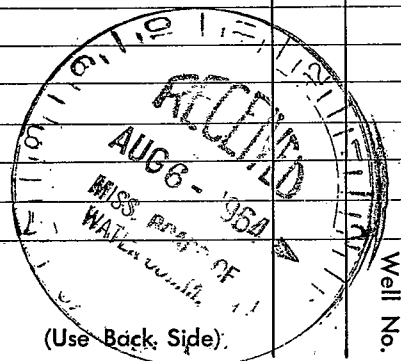

Well No. _____

(Use Back Side).

