

SCOTT MISSISSIPPI BOARD OF WATER COMMISSIONERS

K5  
8-15-60

WATER WELL DRILLERS LOG

K 301

v

Date: 8/15, 1960, Driller: James McGee County Scott  
(Name)


		Description & Color of Materials Sand, Clay, Red Clay, Shell, etc.	Thick- ness Feet	Depth Feet
(1) Owner of Land:	<u>Charles Blossom</u> (Name)			
	<u>Forest, Miss.</u> (Address)	<u>Brown Clay</u>	<u>0</u>	<u>8</u>
(2) Location:	<u>1/4, 1/4, Sec 15 T R</u> <u>6</u> miles <u>West</u> of <u>Forest</u> (distance) (direction) (Nearest Town)	<u>Blue Clay</u>	<u>8</u>	<u>43</u>
		<u>Rock.</u>	<u>43</u>	<u>47</u>
(3) Topography:	<u>X</u> (Hilly) (Flat) (Level)	<u>Blue Clay.</u>	<u>47</u>	<u>246</u>
(4) Purpose of Well:	<u>Farm &amp; Home.</u> (Domestic Irrigation Municipal, Industrial, Other)	<u>Clay &amp; Stks. Rock.</u>	<u>246</u>	<u>266</u>
		<u>Clay</u>	<u>266</u>	<u>312</u>
		<u>Clay &amp; Stks. Rock.</u>	<u>312</u>	<u>352</u>
		<u>Sandy Shell &amp; Clay.</u>	<u>352</u>	<u>372</u>
		<u>Shale.</u>	<u>372</u>	<u>422</u>
		<u>Fine Sand.</u>	<u>422</u>	<u>432</u>
		<u>Shale.</u>	<u>432</u>	<u>440</u>
		<u>Fine Sand.</u>	<u>440</u>	<u>452</u>
		<u>Clay &amp; Stks. Sand.</u>	<u>452</u>	<u>462</u>
		<u>Fine Sand.</u>	<u>462</u>	<u>472</u>
		<u>Clay &amp; Stks. Sand.</u>	<u>472</u>	<u>492</u>
		<u>Sand, (Screen Setting)</u>	<u>492</u>	<u>519</u>
		<u>Clay &amp; Sand.</u>	<u>519</u>	<u>532</u>

Information upon completion of well:

- (1) Diameter 2" inches.
- (2) Total Depth 519 feet.
- (3) Water Level 260 feet below top of ground.
- (4) Cased to 504', Size 2"
- (5) Screen: Size 2", Length 15'
- (6) Were any formations sealed against pollution?  
no yes, X no.

If YES depth of formation \_\_\_\_\_  
Why \_\_\_\_\_

Drillers Remarks: Fair Well

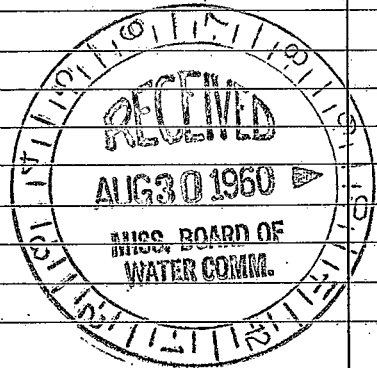

(Use Back Side)

Well No.

Mail this copy to Board of Water Commissioners 429 Miss. St. Jackson, Miss

