

SCOTT


WATER WELL DRILLERS LOG

4

SKT
11-27-61

Date: 11/27, 1961, Driller: Johnnie Beasley County Scott
(Name)

	Description & Color of Materials Sand, Clay, Red Clay, Shell, etc.	Thick- ness Feet	Depth Feet
(1) Owner of land: <u>Billy M. Hatch</u> (Name)	<u>Yellow clay.</u>	<u>0-</u>	<u>27</u>
<u>Rt. 1. Morton, Miss.</u> (Address)	<u>Blue clay.</u>	<u>27-</u>	<u>82</u>
Go East on 80 Hwy. out of Morton for (2) Location: <u>1/4</u> , <u>1/4</u> , Sec. <u>16</u> , T. <u>1</u> R. <u>1</u> 2 miles to Kalem Groc. store. Turn North and this well is just north of (distance) (direction) (Nearest Town)	<u>Lime & blue clay.</u>	<u>82-</u>	<u>174</u>
the grocery store.	<u>Soft clay & silt.</u>	<u>174-</u>	<u>222</u>
(3) Topography: <u>x</u> (Hilly) (Flat) (Level)	<u>Fine sand.</u>	<u>222-</u>	<u>232</u>
(4) Purpose of Well: <u>Dome stic.</u> (Domestic Irrigation Municipal, Industrial, Other)	<u>Fine sand & shale.</u>	<u>232-</u>	<u>240</u>
Information upon completion of well:	<u>Fine sand.</u>	<u>240-</u>	<u>246</u>
(1) Diameter <u>2</u> inches.	<u>Sand & shale.</u>	<u>246</u>	<u>252</u>
(2) Total Depth <u>352</u> feet.	<u>Shale.</u>	<u>252-</u>	<u>270</u>
(3) Water Level <u>132</u> feet below top of ground.	<u>Fine sand.</u>	<u>270-</u>	<u>275</u>
(4) Cased to <u>342'</u> , Size <u>2"</u>	<u>Shale.</u>	<u>275-</u>	<u>290</u>
(5) Screen: Size <u>2"</u> , Length <u>10'</u>	<u>Fine sand.</u>	<u>290-</u>	<u>294</u>
(6) Were any formations sealed against pollution? yes, <u>x</u> no.	<u>Shale.</u>	<u>294-</u>	<u>297</u>
If YES depth of formation _____	<u>Fine sand.</u>	<u>297-</u>	<u>300</u>
Why _____	<u>Shale.</u>	<u>300-</u>	<u>310</u>
Drillers Remarks: <u>Good well.</u>	<u>Silt & sand.</u>	<u>310-</u>	<u>317</u>
_____	<u>Fine sand.</u>	<u>317-</u>	<u>342</u>
_____	<u>Sand. (Screen setting)</u>	<u>342-</u>	<u>352</u>

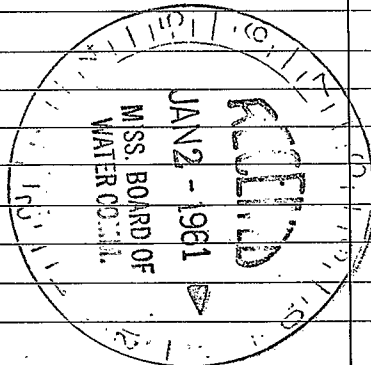

(Use Back Side)

Well No.

