

SCOTT MISSISSIPPI BOARD OF WATER COMMISSIONERS

KS
12-8-62

WATER WELL DRILLERS LOG

Date: 12-8, 1962, Driller: LEACH County SCOTT
(Name)

(1) Owner of Land: WALTER SIMS
(Name)

RT-1-Morton Miss
(Address)

(2) Location: 1/4, 1/4, Sec. 15 T. R
617E

5 miles W, of Forest
(distance) (direction) (Nearest Town)

(3) Topography: Flat
(Hilly) (Flat) (Level)

(4) Purpose of Well: Domestic
(Domestic Irrigation
Municipal, Industrial, Other)

Description & Color of Materials Sand, Clay, Red Clay, Shell, etc.	Thick- ness Feet	Depth Feet
Clay	300	
Sand	105	
		405

Information upon completion of well:

(1) Diameter 2" inches.

(2) Total Depth 405 feet.

(3) Water Level 150 feet below top of ground.

(4) Cased to 405, Size 2"


(5) Screen: Size 2", Length 6'

(6) Were any formations sealed against pollution?
 yes, no.

If YES depth of formation 407'

Why sand

Drillers Remarks:

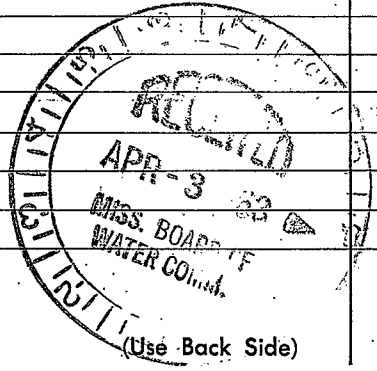

Well No.

