

SCOTT MISSISSIPPI BOARD OF WATER COMMISSIONERS

K 9

10-6-65

WATER WELL DRILLERS LOG

Date: 10/6, 1965, Driller: Forest Whiting County Scott
 (Name)

(1) Owner of Land: Glenn D. Mc Gee
 (Name)
Box 24 Forest, Miss
 (Address)

(2) Location: 1/4, 1/4, Sec. 2 T. R
at of Kalam
 (distance) (direction) (Nearest Town)

(3) Topography: _____
 (Hilly) (Flat) (Level)

(4) Purpose of Well: Home
 (Domestic Irrigation, Municipal, Industrial, Other)

Description & Color of Materials Sand, Clay, Red Clay, Shell, etc.	Thick- ness Feet	Depth Feet
Brown Clay		27
Blue Clay		172
Clay + Shls Sand		212
Shale		249
Rock		257
Shale		262
Sandy shell		272
Fine Sand		278
Fine Sand + Rock		282
Fine Sand		287
Shale		317
Shals + Shls + Sand		357
Shales		367
Shals + Sand		377
Sand		397

Information upon completion of well:

(1) Diameter 2 inches.

(2) Total Depth 397 feet.

(3) Water Level 182 feet below top of ground.

(4) Cased to 387, Size 2"


(5) Screen: Size 2", Length 10ft

(6) Were any formations sealed against pollution?
 _____ yes, _____ no.

If YES depth of formation _____

Why _____

Drillers Remarks: _____

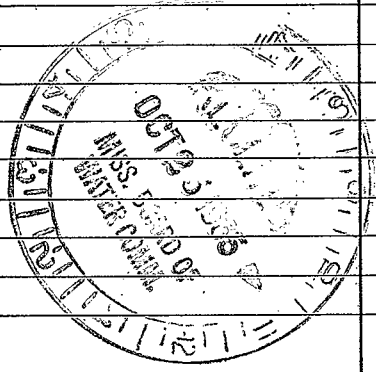

(Use Back Side)

Well No.

