

Scott  
 R 11  
 6-69

MISSISSIPPI  
 BOARD OF WATER COMMISSIONERS  
 416 North State Street  
 Jackson, Mississippi 39201

CODED

WATER WELL DRILLERS LOG

June 1969 Wilkerson Drilling Service Scott  
 date well completed LAKE firm name county well located

LANDOWNER:

description of formations encountered

from

to

Mr Dennis Chancellor  
 Eastwood Dr.  
 Forest MISS  
 (mailing address)

yellow clay	0	30
blue	30	180
Rock	180	184
sand & Rock	184	189
blue shale	189	220
brown shale	220	280
Rock	280	282
SAND	282	346

WELL LOCATION:

sec. 33 T 6 N R 7 E  
 S W  
 10 miles S. E. of Manton  
 (distance) (direction) (nearest town)

WELL PURPOSE:

FARM  
 (home, irrigation, municipal, industrial)

WELL COMPLETION DATA:

- (1) diameter (inches) 2
- (2) total depth (feet) 346
- (3) static water level (feet) 132 below above top of ground.
- (4) casing GALV, 336,  
 (material) (depth)
- \_\_\_\_\_ If telescope see back.  
 (size)
- (5) screen 10, 346  
 (length) (depth to top)
- 2, Stainless Steel  
 (size) (material)
- (6) pump 3, 13  
 (HP) (yield gpm)
- Elec  
 (type power)
- (7) electric log No  
 (yes or no)

\_\_\_\_\_ (organization running log)

(8) how well bottom plugged 2-2" PVC


JUN 30 1969

MISS. BD. OF  
 WATER COMM.

DRILLERS REMARKS:

If well telescopes please sketch and show depths.

GROUND LEVEL

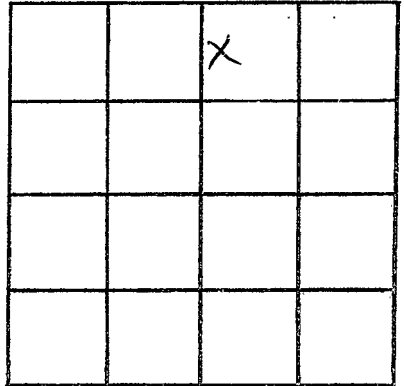

SECTION 33

Please indicate well location X.

ADDITIONAL INFORMATION

If more than one screen,  
show locations of each on sketch.