

SCOTT
K12
8-25-70

MISSISSIPPI
BOARD OF WATER COMMISSIONERS
416 North State Street
Jackson, Mississippi 39201

INDEXED

WATER WELL DRILLERS LOG

8/25 1970 date well completed Forest Drilling firm name Scott county well located

LANDOWNER:

Pearl River Basin Development Dist
DeLoach & Riding Trail
Brewville National Forest
Scott County, Mississippi
(mailing address)

description of formations encountered

from to

WELL LOCATION:

sec. 15 T 6 N R 7 E
5 miles W of Forest
(distance) (direction) (nearest town)

WELL PURPOSE:

PARK
(home, irrigation, municipal, industrial)

WELL COMPLETION DATA:

- (1) diameter (inches) 4" x 2 1/2"
- (2) total depth (feet) 807'
- (3) static water level (feet) 237' below top of ground.
- (4) casing Steel, 783' (material), (depth)
360' - 4" (size)
423' - 2 1/2" if telescope see back.
- (5) screen 15', 783' (length), (depth to top)
4" Stainless Steel (size), (material)
- (6) pump 2 - 14 stage 15 (HP), (yield gpm)
Elect (type power)
- (7) electric log yes (yes or no)
Miss. Geological (organization running log)
- (8) how well bottom plugged 2" Backward Valve

yellow clay	0	24
Blue clay	24	26
yellow clay	26	36
Blue clay	36	203
soft black clay	203	243
soft clay, silt, & lime	243	278
fine sand + also shale	278	300
soft shale + silt	300	363
fine sand + also shale	363	403
fine sand	403	440
soft shale	440	463
hard shale	463	544
shale, rock, & also rock	544	563
shale, silt, + also sand	563	770
sand	770	808
fine sand	808	818
shale	818	826

INDEXED


AUG 27 1970

DRILLERS REMARKS:

MISS. BD. OF
WATER COMM.

If well telescopes please sketch and show depths.

GROUND LEVEL

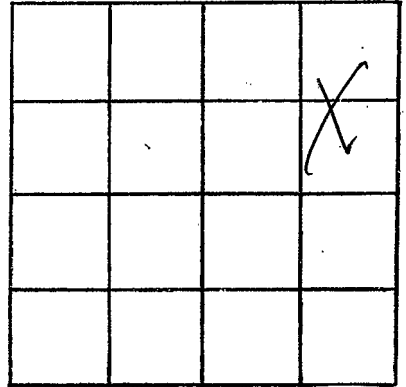

SECTION 15

Please indicate well location X.

ADDITIONAL INFORMATION

If more than one screen,
show locations of each on sketch.