

Scott
K17
10-27-71

MISSISSIPPI
BOARD OF WATER COMMISSIONERS
416 North State Street
Jackson, Mississippi 39201

CODED

WATER WELL DRILLERS LOG

Oct 27 1971 date well completed
Wilkerson Drilling firm name
Scott county well located

LANDOWNER: Mr B. C. Rogers
Morton, Miss

description of formations encountered	depth	
	from	to
yellow clay	0'	10'
Blue "	10	300'
1/2 clay - sandy	300	315
sand -	315	378
	378	425

(mailing address)

WELL LOCATION:
sec. 19 T. 6 N R. 7 E
3 miles S.E. of Morton
(distance) (direction) (nearest town)

WELL PURPOSE: Home
(home, irrigation, municipal, industrial)

WELL COMPLETION DATA:

- (1) diameter (inches) 2
- (2) total depth (feet) 425
- (3) static water level (feet) 115 below top of ground.
- (4) casing galv (material), 115 (depth)
- (size) if telescope see back.
- (5) screen 10 (length), (depth to top)
2 (size), S. steel (material)
- (6) pump 1 (HP), 10 (yield gpm)
elec (type power)
- (7) electric log no (yes or no)
- (organization running log)
- (8) how well bottom plugged B. W. U.

CODED


NOV 22 1971

MISSISSIPPI BOARD OF WATER COMMISSIONERS

DRILLERS REMARKS:

If well telescopes please sketch and show depths.

GROUND LEVEL

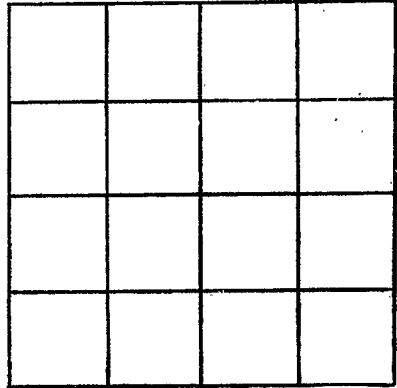

SECTION _____

Please indicate well location X.

ADDITIONAL INFORMATION

A series of horizontal lines for recording additional information, starting below the 'ADDITIONAL INFORMATION' header and extending to the bottom of the page.

More than one screen,
Locations of each on sketch.