

MISSISSIPPI
BOARD OF WATER COMMISSIONERS
416 North State Street
Jackson, Mississippi 39201

WATER WELL DRILLERS LOG

CODED

SCOTT
K18
10-29-72

Oct 29 1972 date well completed
Wilkinson Drills. firm name
Scott county well located

LANDOWNER: B. E. Rogers

Morton
Miss

(mailing address)

description of formations encountered

from to

| | | |
|-------------------|-----|-----|
| Yellow Clay | 10 | 20 |
| Blue " " | 20 | 126 |
| Yellow " " + Sand | 126 | 325 |
| Fine Sand | 325 | 335 |
| Water " " | 335 | 366 |

WELL LOCATION:

sec. 18 T. 6 N R. 7 E
2 miles NE of Morton
(distance) (direction) (nearest town)

WELL PURPOSE: Home
(home, irrigation, municipal, industrial)

WELL COMPLETION DATA:

- (1) diameter (inches) 2
(2) total depth (feet) 376
(3) static water level (feet) 160 below above top of ground.
(4) casing Water 366
(material) (depth)

(size) if telescope see back.

- (5) screen 10' 3' Steel
(length) (depth to top)
2 (size) (material)

- (6) pump 5 (HP) (yield gpm)
Elec (type power)

- (7) electric log no (yes or no)
(organization running log)


- (8) how well bottom plugged B. W. 7/8

DRILLERS REMARKS:

NOV 20 1972

if well telescopes please
sketch and show depths.

GROUND LEVEL

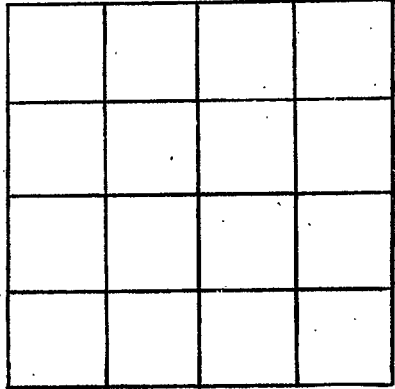

SECTION _____

Please indicate well location X.

ADDITIONAL INFORMATION

If more than one screen,
show locations of each on sketch.