

**MISSISSIPPI
BOARD OF WATER COMMISSIONERS**
416 North State Street
Jackson, Mississippi 39201

WATER WELL DRILLERS LOG

SCOTT
K 19
6/74

MSGW 3910 *Forest Drilling Ser. Scott*
date well completed firm name county well located

LANDOWNER:
Melpum Lumber Co.
Morton, Miss
(mailing address)

WELL LOCATION:
sec. 19 T 6 N R 7 E
1 miles E of Morton
(distance) (direction) (nearest town)

WELL PURPOSE: IND.
(home, irrigation, municipal, industrial)

- WELL COMPLETION DATA:**
- diameter (inches) 6"
 - total depth (feet) 786'
 - static water level (feet) 235' below top of ground.
 - casing Galv. 940'
(material) (depth)
6" if telescope see back.
(size)
 - screen 40' 740'
(length) (depth to top)
6" 5' Steel
(size) (material)
 - pump 15 110
(HP) (yield gpm)
110V
(type power)
 - electric log No
(yes or no)
- (organization running log)
- (8) how well bottom plugged 3"
Backwash Valve

description of formations encountered	from	to
<i>Brown Clay</i>	0	25
<i>Blue Clay</i>	25	120
<i>Clay + Sh. rock</i>	120	203
<i>O clay</i>	203	220
<i>rock</i>	220	224
<i>Shale + Silt</i>	224	228
<i>fine sand</i>	228	290
<i>Clay + Sh. Sand</i>	290	474
<i>Hard Shale</i>	474	534
<i>Rock</i>	534	57
<i>Shale</i>	557	65
<i>Rock</i>	565	69
<i>Shale + Rock</i>	569	640
<i>Shale + Sh. Sand</i>	640	703
<i>fine Sand</i>	703	780

CODED

RECORDED


JUL 8 1974

MISS. BD. OF WATER COM.

DRILLERS REMARKS:

If well telescopes please sketch and show depths.

GROUND LEVEL

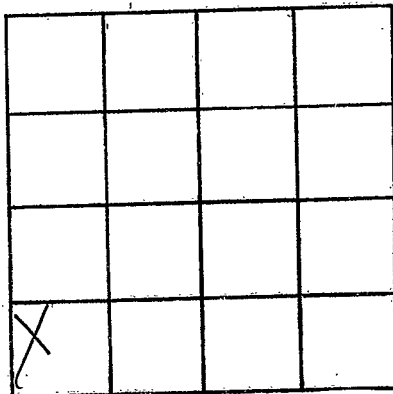

SECTION 17

Please indicate well location X.

ADDITIONAL INFORMATION

If more than one screen,
show locations of each on sketch.