

K-26

MISSISSIPPI DEPARTMENT OF ENVIRONMENTAL QUALITY

Office of Land and Water Resources

COUNTY WELL LOCATED
SCOTT

WELL NUMBER **9-20-02** CODED

DATE WELL COMPLETED

PERMIT NUMBER

NAME OF DRILLING FIRM
Forbes well service

P. O. Box 10631
Jackson, MS 39289-0631
WATER WELL DRILLERS LOG

NAME & MAILING ADDRESS OF LANDOWNER
VICTOR PHAN
MORTON MS.

Latitude: **32°19'01"N**
Longitude: **89°31'56"W**

WELL LOCATION: SEC **36** TOWNSHIP **6 S** RANGE **7 E**

DISTANCE **6** Miles DIRECTION **E** of NEAREST TOWN **MORTON**

OTHER LANDMARK

WELL PURPOSE: Home, Irrigation, Municipal, Industrial, Fish Pond, etc.
CHICKEN HOUSES

PUMP DATA

PUMP TYPE (Circle One):
 Submersible Turbine Jet Flowing Well,
Other (Describe)

POWER TYPE (Circle One):
 Electric Tractor Diesel Gasoline Butane,
Other (Describe) **H/P 5**

DESCRIPTION OF FORMATIONS ENCOUNTERED	FROM	TO
RED CLAY	0	40
CLAY	40	180
SAND & CLAY	180	360
SAND	360	440
CLAY	440	460
SAND	460	530
CLAY	530	540

RECEIVED
OCT 10 2002
BY: OLWR

Top of Lap Pipe or Reduction in Casing

FEET IF TELESCOPED OR MORE THAN ONE SCREEN: USE BACK PAGE

WELL DATA

Well Depth **530** Casing Diameter (In.) **4"** Casing Length (Ft.) **510**

Type of Casing **PVC** Hole Depth **540** Depth to Static Water Level **100'**

TYPE OF COMPLETION: (Circle One or More):
 Gravel Packed Underreamed Telescoped,
 Natural Development Open Hole Other
(Describe)

WELL GROUTED TO A DEPTH OF **12** FEET
Type Grout (circle one): Cement, Bentonite, or Mix

SCREEN DATA

Diameter - Inches	Length - Feet	Slot Size - Inches
4"	(10)	006

Screen Type **PVC** Depth to Bottom - Feet **530'**

I certify that the well was drilled, constructed and completed in accordance with all applicable Requirements of the Mississippi Department of Environmental Quality and/or the Mississippi Department of Health regulations and state laws.


John R. Forbes
Signature of Licensed Driller and License No.

9-27-02
Date

Additional Information Required On Back

If well telescopes please sketch and show depths.

GROUND LEVEL

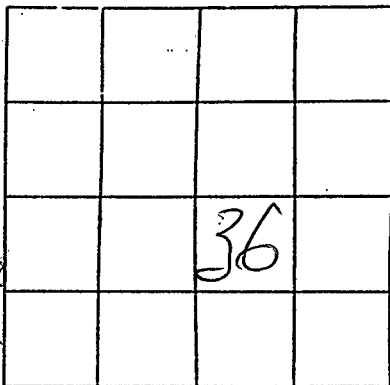

R. 7 E
SECTION 36

Please indicate well location X.

Pump Capacity (GPM)	No. of Stages	Setting Depth
35	29	210 FT.

PUMP TEST

Well yielded 65 GPM with
a drawdown of _____ ft.
after 12 hours of pumping

LOG DATA

TYPE OF LOG RUN (Circle One):
 Electric, Gamma Ray, Density, Sonic, Neutron,
 Other (Describe) GR-SP RESB-16

No Log Run.

Name of Organization Running Log

STATE

32-64

GEOLOGIC DATA (Office Use Only)

Surface Elev.	Geologic Unit	Unit Thickness	Depth to Top
Subs. SWL	Date	Analysis	Aquifer Test

Driller's Remarks

If more than one screen,
show location of each on sketch.