

Scott
L3
11-66

MISSISSIPPI BOARD OF WATER COMMISSIONERS

WATER WELL DRILLERS LOG

Date: 11/9, 1966, Driller: Scott Mississippi County Scott
(Name)

(1) Owner of Land: Keith Gunn
(Name)
Just, Miss.
(Address)

(2) Location: NE 1/4, NE 1/4, Sec. 9 T6 R8E
1 1/2 miles N of Just
(distance) (direction) (Nearest Town)

(3) Topography: X (Hilly) X (Flat) (Level)

(4) Purpose of Well: Home
(Domestic Irrigation, Municipal, Industrial, Other)

Description & Color of Materials Sand, Clay, Red Clay, Shell, etc.	Thick- ness Feet	Depth Feet
Brown Clay	31	31
Clay + Stone Rock	9	40
Bl Clay + Sths Fr. Rock	22	62
Blue Clay	28	90
Rock	2	92
Blue Clay	30	122
Clay + Silt Sand	26	148
Rock	2	150
Fine sand	25	175
Clay	21	196
F. Sand + Sths Clay	7	203
Clay	10	213
F. Sand + Sths Clay	31	244
Clay	37	281
Fine sand	29	310

Information upon completion of well:

(1) Diameter 2 inches.

(2) Total Depth 310 feet.

(3) Water Level 111 feet below top of ground.

(4) Cased to 300, Size 2"


(5) Screen: Size 2", Length 10ft.

(6) Were any formations sealed against pollution?
 _____ yes, X no.

If YES depth of formation _____

Why _____

Drillers Remarks: _____

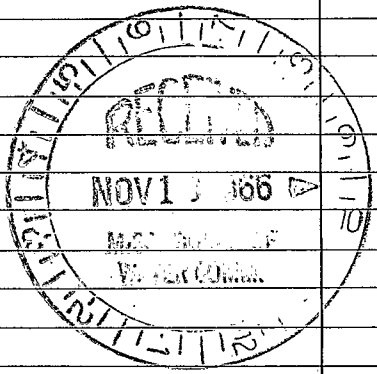

(Use Back Side)

Well No.

100

100