

Scott
7-66

MISSISSIPPI BOARD OF WATER COMMISSIONERS

WATER WELL DRILLERS LOG

Date: 7/20, 1966, Driller: Scott Drilling County Scott
(Name)

(1) Owner of Land: First Country Club
(Name)
First, Miss.
(Address)

(2) Location: NE 1/4, NE 1/4, Sec. 32 T⁶ N R⁸ E

4 miles South, of First
(distance) (direction) (Nearest Town)

(3) Topography: 35
(Hilly) (Flat) (Level)

(4) Purpose of Well: Country Club
(Domestic Irrigation
Municipal, Industrial, Other)

Description & Color of Materials Sand, Clay, Red Clay, Shell, etc.	Thick- ness Feet	Depth Feet
Sand	0	9
Chalky Clay		30
Blue Clay		189
Shale + 5th Rock		246
Shale		327
Stiff Clay + Clay		369
Shale		387
Silt		394
Shale		410
Silt + 5th shale		420
Fine Sand (Silt)		430
Fine Sand		502

Information upon completion of well:

(1) Diameter: 4" x 2 1/2" inches.

(2) Total Depth: 502 feet.

(3) Water Level: 157 feet below top of ground.

(4) Cased to: 315ft, Size 4" 1/2"
162ft


(5) Screen: Size 4" 1/2", Length 25ft

(6) Were any formations sealed against pollution?
 yes, no.

If YES depth of formation _____

Why _____

Drillers Remarks: _____

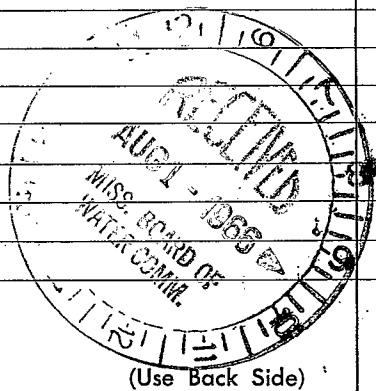

Well No.

