

SCOTT MISSISSIPPI BOARD OF WATER COMMISSIONERS

L 12
9-21-60

WATER WELL DRILLERS LOG

Date: 9-21-, 1960, Driller: Layne-Central Co. County Scott
(Name)

(1) Owner of Land: Town of Forest
(Name)

Forest, Mississippi
(Address)

(2) Location: 1/4, 1/4, Sec 16 T R
miles of
(distance) (direction) (Nearest Town)

(3) Topography: (Hilly) (Flat) (Level)

(4) Purpose of Well: Municipal
(Domestic Irrigation
Municipal, Industrial, Other)


Information upon completion of well:

- (1) Diameter 18" inches.
- (2) Total Depth 351' feet.
- (3) Water Level 119' feet below top of ground.
- (4) Cased to 47', Size 12"
- (5) Screen: Size 12", Length 60'
- (6) Were any formations sealed against pollution?
x yes, no.

If YES depth of formation 280'
Why Required

Drillers Remarks:

Description & Color of Materials Sand, Clay, Red Clay, Shell, etc.	Thick- ness Feet	Depth Feet
Yellow clay	32	0-32
Blue clay	79	32-111
Brown shale	45	111-156
Shale stks-sand	89	156-245
Sandy shale	29	245-274
Sand	76	274-350
Shale	9	350-359

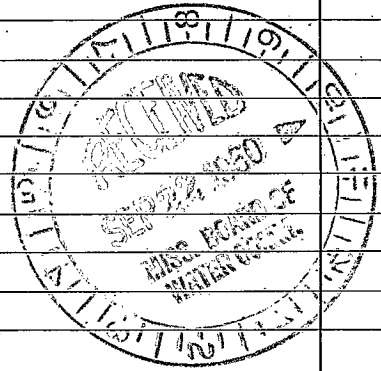

(Use Back Side)

Well No.

(4)

1000

1000

