

Scott
L13
6-64

MISSISSIPPI BOARD OF WATER COMMISSIONERS

WATER WELL DRILLERS LOG

CODED

Date: June 3, 1964, Driller: Robert E. Ratliff County: Scott
(Name)

(1) Owner of Land: Lawn of Forest
(Name)
Forest Mississippi
(Address)

(2) Location: SE $\frac{1}{4}$, NE $\frac{1}{4}$, Sec. 16 T6 R8,
in town miles, of Forest
(distance) (direction) (Nearest Town)

(3) Topography: Flat
(Hilly) (Flat) (Level)

(4) Purpose of Well: Municipal
(Domestic Irrigation
Municipal, Industrial, Other)

Description & Color of Materials Sand, Clay, Red Clay, Shell, etc.	Thick- ness Feet	Depth Feet
Clay	69	69
blue gumbo + rocks	68	137
sand + shale	46	183
sand	192	375
shale	82	457
rock	2	459
shale	30	489
sand	22	511
sand + shale	43	554
good sand	106	660
shale	2	662
good sand	59	721

Information upon completion of well:

(1) Diameter 12 inches.

(2) Total Depth 721 feet.

(3) Water Level 193 feet below top of ground.

(4) Cased to 661', Size 12"

(5) Screen: Size 8", Length 60'


(6) Were any formations sealed against pollution?
 yes, no.

If YES depth of formation Casing Cemented
in place

Why _____

Drillers Remarks: _____

CODED

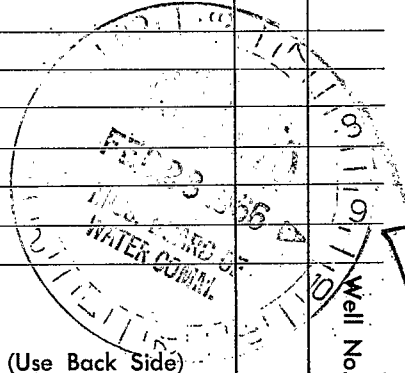

(Use Back Side)

(X)