

SCOTT MISSISSIPPI BOARD OF WATER COMMISSIONERS

L 14
4-28-66

WATER WELL DRILLERS LOG

Date: 4/28, 1966, Driller: Forest Drilling Co. (Name)

(1) Owner of Land: AD Royum
(Name)
Forest Miss
(Address)

(2) Location: 1/4, 1/4, Sec. 11 T. R.
1/2 miles North of Forest
(distance) (direction) (Nearest Town)

(3) Topography: (Hilly) (Flat) (Level)

(4) Purpose of Well: Chickens
(Domestic Irrigation
Municipal, Industrial, Other)

Description & Color of Materials Sand, Clay, Red Clay, Shell, etc.	Thick- ness Feet	Depth Feet
Brown Clay	0	28
Blue Clay		42
Clay + shells fine sand		52
Hard Shell		68
lime rock		78
Clay		102
Rock		106
Clay		112
Clay & Shell		122
Clay		142
Clay + fine sand		172
Clay		278
Clay + shells fine sand		252
Clay		262
Hard Clay		272
Clay		289
Fine sand		302
Fine sand		325

Information upon completion of well:

(1) Diameter 2 inches.

(2) Total Depth 325 feet.

(3) Water Level 100 feet below top of ground.


(4) Cased to 315, Size 2"

(5) Screen: Size 2", Length 10ft.

(6) Were any formations sealed against pollution?
yes, no.

If YES depth of formation _____
Why _____

Drillers Remarks: _____

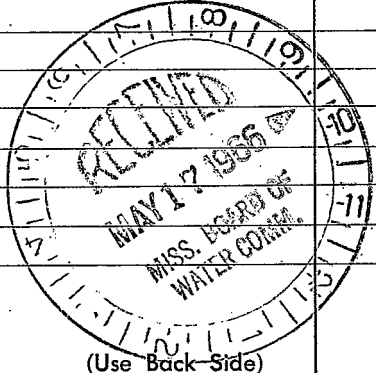

Well No.

(Use Back Side)

