

SCOTT MISSISSIPPI BOARD OF WATER COMMISSIONERS

L 15  
4-15-66

WATER WELL DRILLERS LOG

(3)

Date: 4/15, 19 66, Driller: Forest Drilling County Scott  
(Name)

(1) Owner of Land: Pearlie Johnson  
(Name)  
Rt 1 Forest, Miss  
(Address)

(2) Location: 1/4, 1/4, Sec. 11 T R  
2 miles N. East of Forest  
(distance) (direction) (Nearest Town)  
on Hwy 21

(3) Topography: Level  
(Hilly) (Flat) (Level)

(4) Purpose of Well: Home  
(Domestic Irrigation  
Municipal, Industrial, Other)

Description & Color of Materials Sand, Clay, Red Clay, Shell, etc.	Thick- ness Feet	Depth Feet
Brown Clay	0	20
Rock		22
Blue Clay		72
Clay		102
Clay + 5th Mky Sand		112
Clay		132
Clay + Mky Sand		172
Clay + Fine Sand		187
Fine Sand + 5th Clay		212
Clay		216
Fine Sand		230
Clay + 5th Fine Sand		250
Fine Sand		262

Information upon completion of well:

(1) Diameter 2 inches.

(2) Total Depth 262 feet.

(3) Water Level 76 feet below top of ground.

(4) Cased to 252, Size 2"


(5) Screen: Size 2", Length 10ft.

(6) Were any formations sealed against pollution?  
\_\_\_\_\_ yes, no.

If YES depth of formation \_\_\_\_\_

Why \_\_\_\_\_

Drillers Remarks: \_\_\_\_\_

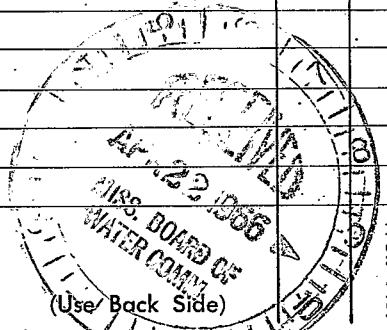

Well No.

