

SCOTT

MISSISSIPPI BOARD OF WATER COMMISSIONERS

L 17

6-10-66

WATER WELL DRILLERS LOG

Date: 6/10, 19 66, Driller: Forest Drilling Co. Scott

(Name)

(1) Owner of Land: Adella Denton

(Name)

Forest, Miss.

(Address)

(2) Location: 1/4, 1/4, Sec. 4 T. R.

1 1/2 miles N. of Forest

(distance)

(direction)

(Nearest Town)

(3) Topography: [check]

(Hilly)

(Flat)

(Level)

(4) Purpose of Well: Home

(Domestic Irrigation, Municipal, Industrial, Other)

Description & Color of Materials Sand, Clay, Red Clay, Shell, etc.

Thickness Feet

Depth Feet

Brown Clay	24
Blue clay + 5th line bed	41
Clay + shell	61
Clay	122
Fine sand + 5th clay	142
Clay	162
Soft Clay	182
Fine sand	204
Fine sand + 5th clay	214
Fine sand	245
Good sand	262

Information upon completion of well:

(1) Diameter 2 inches.

(2) Total Depth 262 feet.

(3) Water Level 50 feet below top of ground.

(4) Cased to 252, Size 2"

(5) Screen: Size 2", Length 10 ft.


(6) Were any formations sealed against pollution?

yes, no.

If YES depth of formation.

Why.

Drillers Remarks:

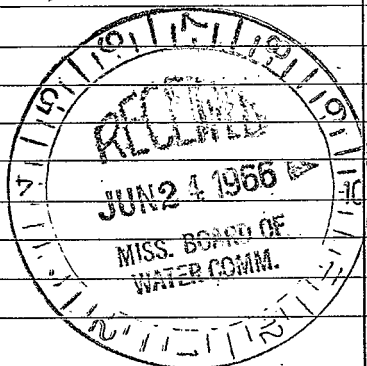

(Use Back Side)

Well No.

