

SCOTT

MISSISSIPPI BOARD OF WATER COMMISSIONERS

6-1-66

WATER WELL DRILLERS LOG


Date: 6-1, 1966, Driller: LEACH, County: SCOTT

Owner of Land: Scott County Drain Elev. Inc., Forest Mills, Address, Location: 1/4, 1/4, Sec. 14 T. R., 8 miles west of lake, Topography: hilly, Purpose of Well: Domestic Irrigation

Table with 3 columns: Description & Color of Materials, Thickness Feet, Depth Feet. Rows include Clay, Sand & Clay, Sand & Silt, Sand.

Information upon completion of well:

(1) Diameter 2 inches, (2) Total Depth 160 feet, (3) Water Level 30 feet below top of ground, (4) Cased to 150, Size 2", (5) Screen: Size 2 1/2", Length 10, (6) Were any formations sealed against pollution? yes, no.

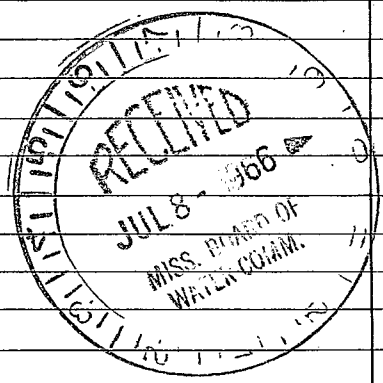

If YES depth of formation, Why, Drillers Remarks, Yield in gpm: 30, Size pump: 3 HP, Type power:

Total 160

