

CODED

MISSISSIPPI
BOARD OF WATER COMMISSIONERS
416 North State Street
Jackson, Mississippi 39201

WATER WELL DRILLERS LOG

Scott
L 22
10-69

oct 1969 Wilkinson Drilling SCOTT
date well completed firm name county well located

LANDOWNER:

Mr C.A. McNeel
Forest MISS
(mailing address)

description of formations encountered

from to

<u>yellow clay</u>	<u>0</u>	<u>30</u>
<u>sand + clay</u>	<u>30</u>	<u>40</u>
<u>blue "</u>	<u>40</u>	<u>50</u>
<u>Rock</u>	<u>50</u>	<u>81</u>
<u>brackish clay</u>	<u>81</u>	<u>170</u>
<u>brackish clay sand</u>	<u>170</u>	<u>190</u>
<u>fine sand</u>	<u>190</u>	<u>210</u>
<u>sand - good</u>	<u>210</u>	<u>215</u>

WELL LOCATION:

sec. 12 T. 6 N. R. 8 E.
S. W.
1 miles NE of Forest
(distance) (direction) (nearest town)

WELL PURPOSE:

home
(home, irrigation, municipal, industrial)

WELL COMPLETION DATA:

- (1) diameter (inches) 2
- (2) total depth (feet) 215
- (3) static water level (feet) 74 below above top of ground.
- (4) casing Galv, 210,
(material) (depth)
5 If telescope see back.
(size)
- (5) screen 5, 215
(length) (depth to top)
2, stainless
(size) (material)
- (6) pump 2, 8
(HP) (yield gpm)
elec
(type power)
- (7) electric log _____
(yes or no)


(organization running log)
- (8) how well bottom plugged 2 - Good

DRILLERS REMARKS:

NOV 27 1969
MISSISSIPPI
BOARD OF WATER COMMISSIONERS

If well telescopes please sketch and show depths.

GROUND LEVEL

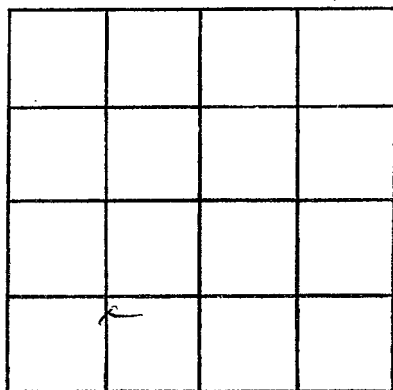

SECTION 12

Please indicate well location X.

ADDITIONAL INFORMATION

If more than one screen,
show locations of each on sketch.