

COPY

MISSISSIPPI  
BOARD OF WATER COMMISSIONERS  
416 North State Street  
Jackson, Mississippi 39201

WATER WELL DRILLERS LOG

Scott  
L 24  
1-20

Jan 1970 Wilkerson Drilling Scott  
date well completed firm name county well located

LANDOWNER: Clyde Chism  
Forest Miss  
(mailing address)

WELL LOCATION:  
sec 12 T 6 N R 8 E  
1/4 miles NE of Forest  
(distance) (direction) (nearest town)

WELL PURPOSE: home  
(home, irrigation, municipal, industrial)

WELL COMPLETION DATA:

- (1) diameter (inches) 2
- (2) total depth (feet) 215
- (3) static water level (feet) 56 below top of ground.
- (4) casing GALV, 210, (material) (depth)
- (size) If telescope see back.
- (5) screen 5, 215 (length) (depth to top)
- 2, STAINLESS (size) (material)
- (6) pump 2, 10 (HP) (yield gpm)
- 5/100 (type power)
- (7) electric log NO (yes or no)
- (organization running log)
- (8) how well bottom plugged 2 BWC

description of formations encountered	from	to
yellow clay	0	35
sandy clay	30	40
blue w	40	81
Rock	81	83
brown	83	170
brown water	170	190
fine sand	190	195
good sand	195	220

COPY


MAR 10 1970

DRILLERS REMARKS:

MISS. BD. OF  
WATER COM.

If well telescopes please sketch and show depths.

GROUND LEVEL

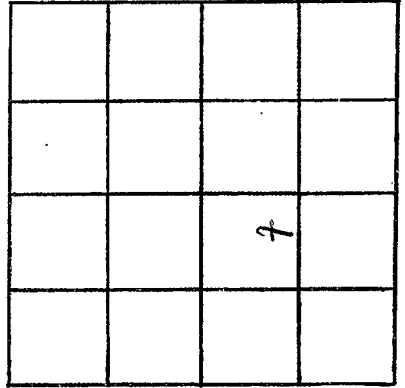

SECTION 12

Please indicate well location X.

ADDITIONAL INFORMATION

If more than one screen,  
show locations of each on sketch.