

SCOTT
L29
11-30-72
Log # 110

MISSISSIPPI
BOARD OF WATER COMMISSIONERS
416 North State Street
Jackson, Mississippi 39201
Forest Mullin
WATER WELL DRILLERS LOG

CODED

11/30 1972 City of Forest firm name Scott county well located

LANDOWNER:	description of formations encountered	from	to
City of Forest	Brown Clay	0	23
	Blue Clay	23	61
	Blue clay + stone Lime	61	81
(mailing address)	Clay + Silt + Sand	81	122
WELL LOCATION:	Clay + Lime Sand	122	143
sec. 10 T 6N R 8 E	Soft Clay + silt	143	163
S	Soft Clay + fine sand	163	183
miles of Forest	clay, fine sand + other clay	183	204
(distance) (direction) (nearest town)	fine sand	204	274
WELL PURPOSE: Test well # 1	Soft clay + silt	274	286
(home, irrigation, municipal, industrial)	Clay	286	292
WELL COMPLETION DATA:	fine sand	292	322
(1) diameter (inches)	Clay	322	327
(2) total depth (feet)	Shale	327	402
(3) static water level (feet) below top of ground.	rock	402	404
(4) casing (material) (depth)	Shale + stone Rock	404	430
(size) if telescope see back.	Shale	430	512
(5) screen (length) (depth to top)	Sand + sh. clay	512	532
(size) (material)	sand	532	573
(6) pump (HP) (yield gpm)	Clay + fine sand	573	796
(type power)	Hard Shale	796	856
(7) electric log (yes or no)	Shale + Rock	856	1110
Miss. Geol. (organization running log)	Soft shale	1110	1278
(8) how well bottom plugged			


CONT

DRILLERS REMARKS:
Drill test hole only.

FEB 5 1973

If well telescopes please sketch and show depths.

GROUND LEVEL

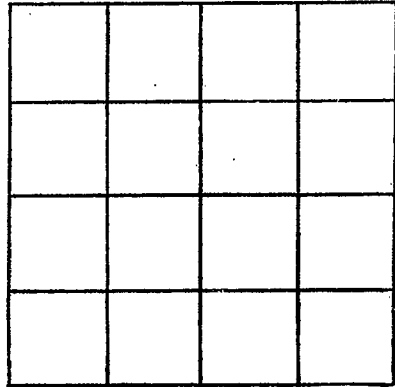

SECTION _____

Please indicate well location X.¹

ADDITIONAL INFORMATION

If more than one screen, show locations of each on sketch.