

**SCOTT**  
L 31  
2-2-73

MISSISSIPPI  
BOARD OF WATER COMMISSIONERS  
416 North State Street  
Jackson, Mississippi 39201

CODED

WATER WELL DRILLERS LOG

February 2 19 73 Forest Drilling Service Scott  
date well completed firm name county well located

LANDOWNER:  
City of Forest  
Forest, Miss  
(mailing address)

WELL LOCATION:  
sec. 21 T. 6 N. R. 8 E  
0 miles S. of Forest  
(distance) (direction) (nearest town)

WELL PURPOSE: Test well # 6  
(home, irrigation, municipal, industrial)

WELL COMPLETION DATA:

- (1) diameter (inches) \_\_\_\_\_
- (2) total depth (feet) 1307
- (3) static water level (feet) \_\_\_\_\_ below top of ground.
- (4) casing (material) \_\_\_\_\_ (depth) \_\_\_\_\_  
(size) \_\_\_\_\_ If telescope see back.
- (5) screen (length) \_\_\_\_\_ (depth to top) \_\_\_\_\_  
(size) \_\_\_\_\_ (material) \_\_\_\_\_
- (6) pump (HP) \_\_\_\_\_ (yield gpm) \_\_\_\_\_  
(type power) \_\_\_\_\_
- (7) electric log no (yes or no)  
no  
(organization running log) \_\_\_\_\_
- (8) how well bottom plugged \_\_\_\_\_


description of formations encountered	from	to
Brown Clay	0	28
Blue clay	28	102
Clay + lime	102	122
Clay	122	163
Clay + Fine Sand	163	225
Fine Sand	225	245
Clay + Fine Sand	245	307
Fine Sand	307	406
Loft Clay	406	491
Clay + rock	491	572
Shale + Sand	572	573
Shale	573	607
Shaley Sand	607	795
Shale + rock	795	998
Green Sand	998	1038
Shale + rock	1038	1203
Shale + Silt Sand	1203	1224
Fine Sand	1224	1245
Sand + Clay	1245	1280
rock	1280	1286
Shale	1286	1290
Rock	1290	1296
Shale	1296	1307
Shale	1307	1327

CODED

DRILLERS REMARKS: Drill Test hole only

If well telescopes please sketch and show depths.

GROUND LEVEL

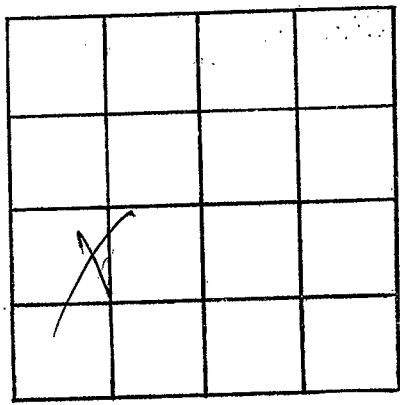

SECTION 21

Please indicate well location X.

ADDITIONAL INFORMATION

Lined area for additional information.

If more than one screen, show locations of each on sketch.