

SCOTT

L36

8-25-73

LOG # 11L

MISSISSIPPI

BOARD OF WATER COMMISSIONERS

416 North State Street

Jackson, Mississippi 39201

CODED

WATER WELL DRILLERS LOG

8/25/1973

Forest Drilling

Scott

date well completed

firm name

county well located

LANDOWNER: Test well #1

description of formations encountered from to

Whinkraft Inc.  
Forest, Miss  
(mailing address)

Brown clay 0 102

Blue clay 102 122

Clay + lime rock 122 123

Blue clay 123 246

Clay + sh rock 246 267

Shale 267 323

Fine sand + clay 323 347

Soft shale 347 430

Hard shale + rock 430 532

Shale 532 707

Fine sand 707 712

Shale 712 733

Shale + fine sand 733 792

Shale 792 814

Shale + sh rock 814 878

Shale 878 1000

Hard rock 1000 1004

Clay + sh rock 1004 1067

Hard shale 1067 1190

Hard rock 1190 1192

Shale 1192 1247

Fine sand 1247 1249

Fine sand + clay 1249 1312

WELL LOCATION:

sec. 17 T. 6 N. R. 8 E.

2 miles W of Forest  
(distance) (direction) (nearest town)

WELL PURPOSE:

(home, irrigation, municipal, industrial)

WELL COMPLETION DATA:

(1) diameter (inches) \_\_\_\_\_

(2) total depth (feet) 1312

(3) static water level (feet) \_\_\_\_\_ below above  
top of ground.

(4) casing \_\_\_\_\_ (material) \_\_\_\_\_ (depth) \_\_\_\_\_

\_\_\_\_\_ (size) if telescope see back.

(5) screen \_\_\_\_\_ (length) \_\_\_\_\_ (depth to top)

\_\_\_\_\_ (size) \_\_\_\_\_ (material)

(6) pump \_\_\_\_\_ (HP) \_\_\_\_\_ (yield gpm)

\_\_\_\_\_ (type power)

(7) electric log Yes (yes or no)

U.S. Geo.  
(organization running log)

(8) how well bottom plugged \_\_\_\_\_


DRILLERS REMARKS:

NOV 1 1973

MISS. WATER

If well telescopes please sketch and show depths.

GROUND LEVEL

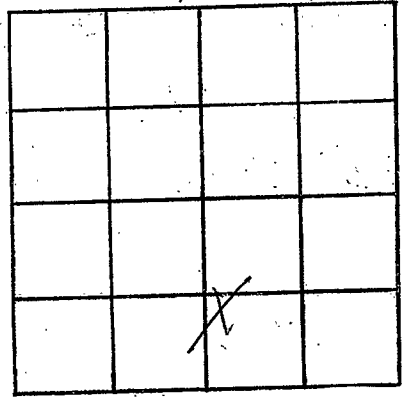

SECTION 17

Please indicate well location X.

ADDITIONAL INFORMATION

Lined area for additional information.

If more than one screen, show locations of each on sketch.