

SCOTT
L38
10-2-73
E Log # 118

MISSISSIPPI
BOARD OF WATER COMMISSIONERS
416 North State Street
Jackson, Mississippi 39201

CODED

WATER WELL DRILLERS LOG

date well completed 10/2 1973 firm name Forest Drilling county well located Scott

LANDOWNER: Just well # 8
City of Forest
Forest Miss
(mailing address)

WELL LOCATION:
sec. 8 T. 6 N. R. 8 E.
S. W. W.
(distance) miles (direction) of (nearest town)

WELL PURPOSE: Just well
(home, irrigation, municipal, industrial)

- WELL COMPLETION DATA:
- (1) diameter (inches) _____
 - (2) total depth (feet) 1316
 - (3) static water level (feet) _____ below
top of ground. above
 - (4) casing _____
(material) (depth)
 - _____ if telescope see back.
(size)
 - (5) screen _____
(length) (depth to top)
 - _____ (size) _____ (material)
 - (6) pump _____
(HP) (yield gpm)
 - _____ (type power)
 - (7) electric log yes
(yes or no)
 - W.S. Geo. McG
(organization running log)
 - (8) how well bottom plugged _____

description of formations encountered	from	to
Brown Clay	0	19
Blue clay	19	61
Clay + lime Rock	61	122
Clay	122	183
Clay + Silt Sand	183	225
Clay	225	250
Fine Sand	250	265
Clay + Silt	265	286
Fine Sand	286	384
Clay	384	389
Clay + St. rock	389	430
Shale	430	466
rock	466	470
Shale + st. rock	470	492
Shale	492	552
Shale + St. Fine Sand	552	652
Fine Sand + st. rock	652	712
Shale + st. rock	712	732
Shale	732	792
Shale + St. rock	792	815
Shale	815	920
Shale + rock	920	941
rock	941	945
Shale + rock	945	1150
Shale	1150	1185
Shale + Fine Sand	1185	1192
Fine Sand + Clay	1192	1245
Fine Sand	1245	1273
Shale	1273	1316


DRILLERS REMARKS:

NOV 1 1973

MISS. SD
WATER

If well telescopes please sketch and show depths.

GROUND LEVEL

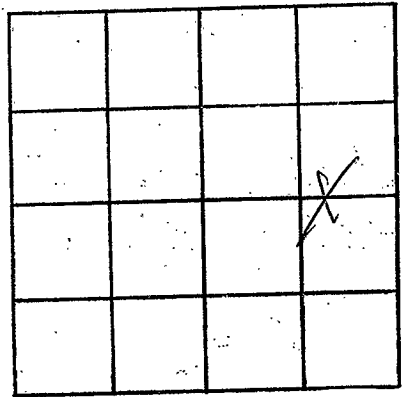

SECTION ~~88~~ 8

Please indicate well location X.

ADDITIONAL INFORMATION

Lined area for additional information.

If more than one screen, show locations of each on sketch.